


T10S. R.3&4W.M.

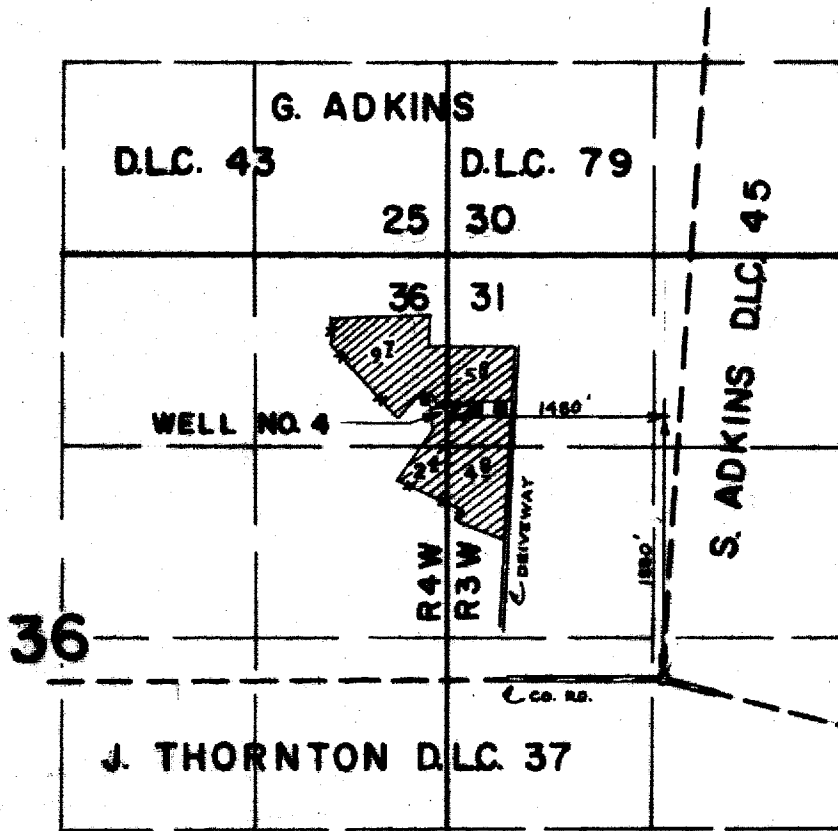

FINAL PROOF SURVEY UNDER

Application No. G-2559 Permit No. G-2436
IN NAME OF

RUSSELL H. and JESSIE E. PARKER

Surveyed APRIL 4 1966, by *V. James*