


T. 15 S. R. 4 W. W.M.

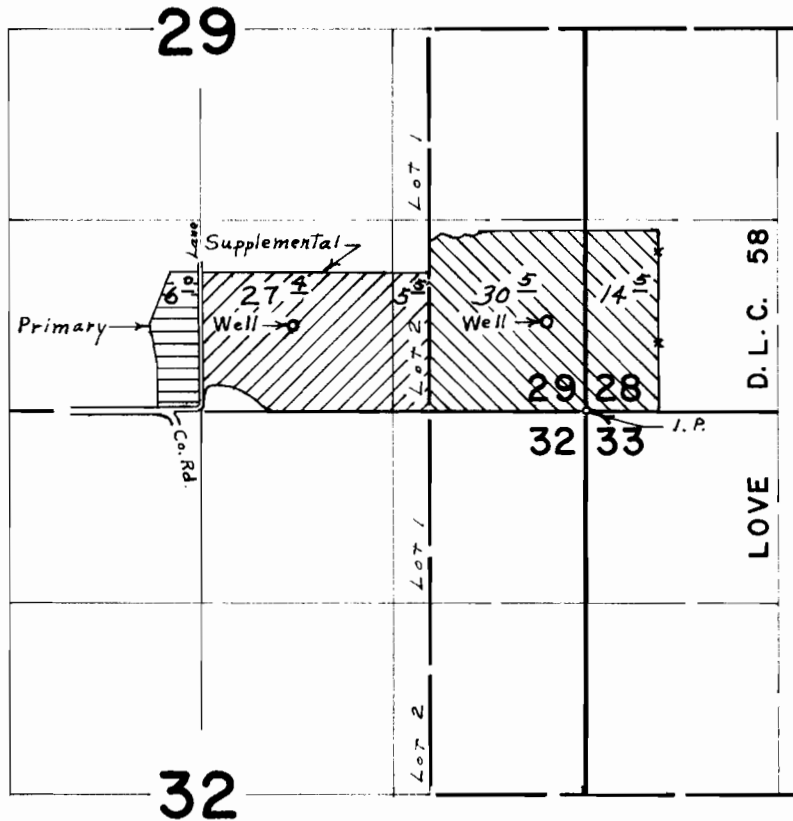


Wells located: 590' N. & 2000' W.; 620' N. & 260' W., both from SE. Cor. Sec. 29

FINAL PROOF SURVEY

G-3370
G-3561

G-3175
G-3359

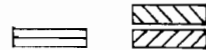

JENS REERSLEV

June 10, 1970 L. E. Gould