


76049  
312-88

# T.6N.R.35E.W.M.

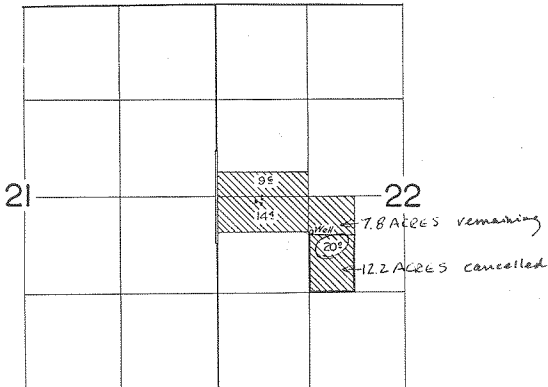

## FINAL PROOF SURVEY UNDER

12.2 acres  
cancelled in  
NE/SW Sec. 22  
V. 53 P. 490

Application No. G-2105 Permit No. G-1961  
IN NAME OF

BETTY ANNE CRIMINS

Surveyed April 25 1962, by *R. Jackson*