


6834

T 7561
47921
76055
T 7561
T 9346

T.34S. R.19E., W.M.

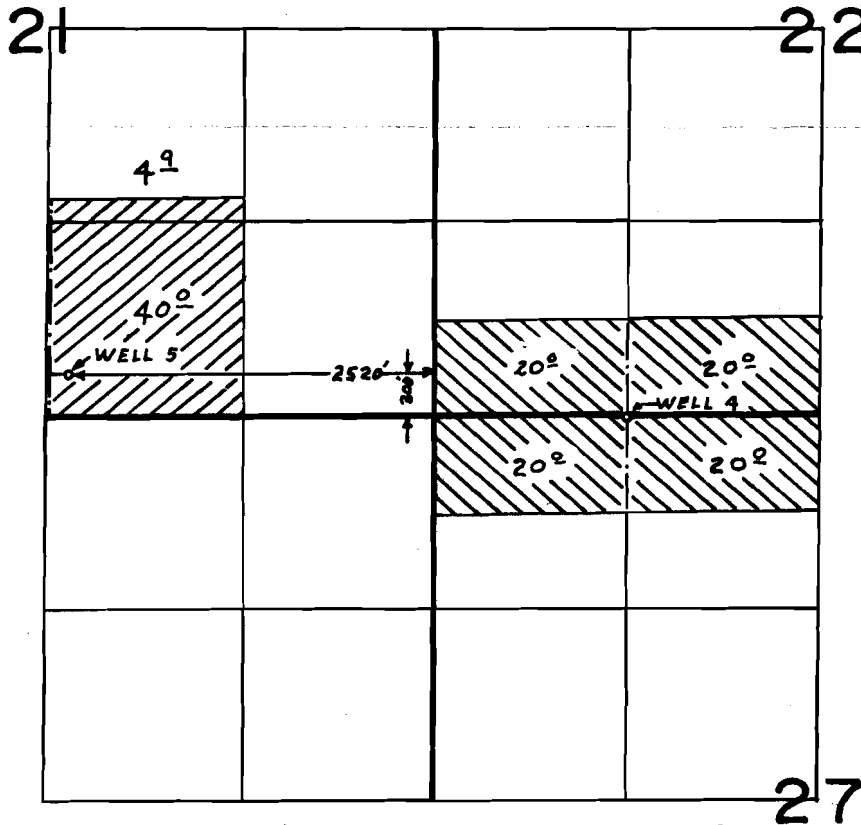

WELL 4 LOC. 16'S. & 1320' E. FROM N.W. COR. SEC. 27

-  WELL 5
-  WELL 4

FINAL PROOF SURVEY
UNDER

See Transfer Map
T 7561

Application No. G-7424.. Permit No. G-6834..
IN NAME OF

ERROL M. & EVELYN R. NEWTON

Solheim

Surveyed JUL. 20., 1977., by D.M. NORBY.....


G 6834

RECEIVED

JUL 1 1976

WATER RESOURCES DEPT.
SALEM, OREGON

T. 34 S. R. 19 E. W.M.

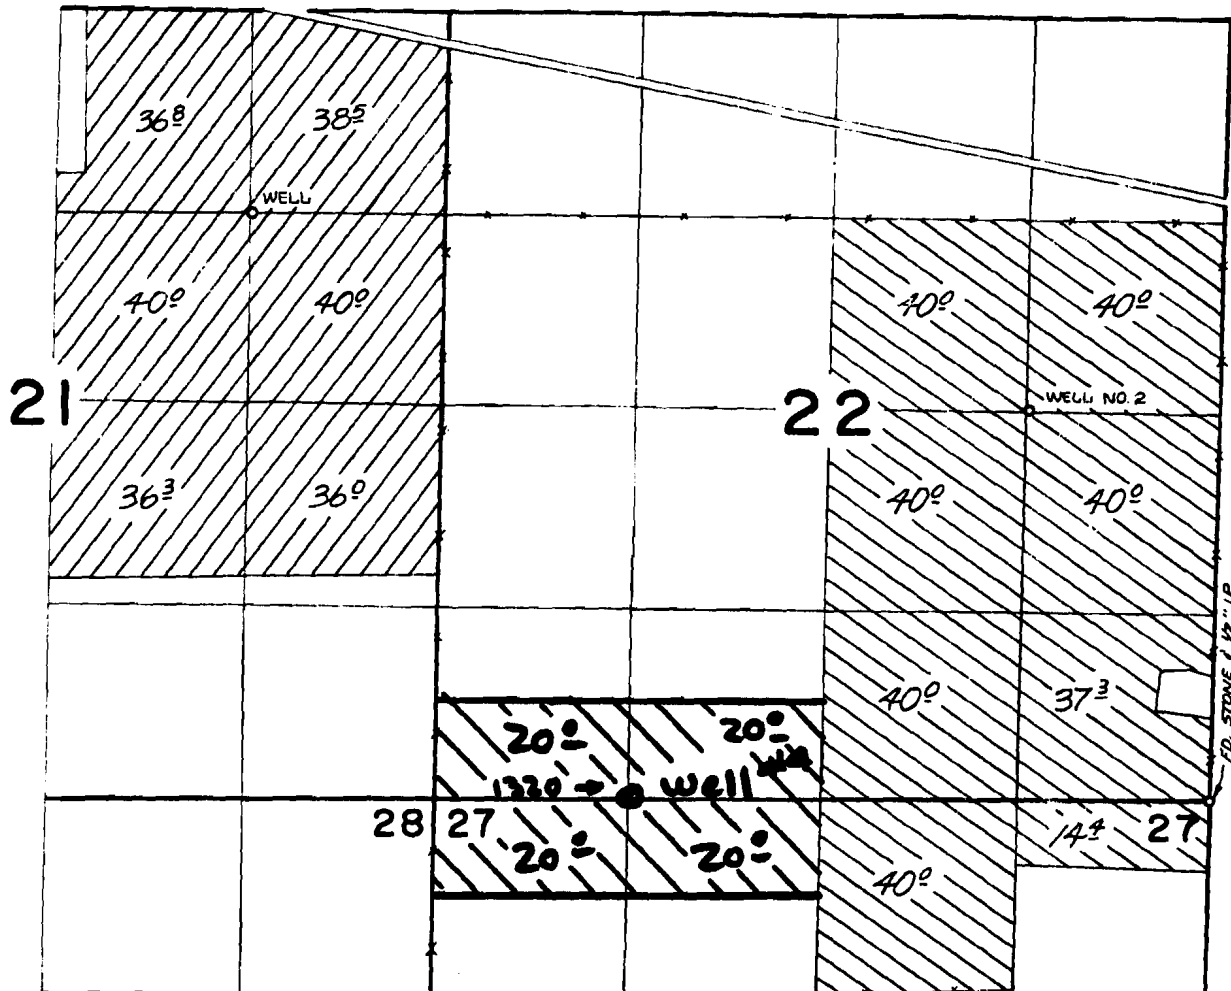

WELL, (PERMIT G4826) 1310'S. & 1330'E. FROM N. 1/4 COR. SEC. 21
WELL NO. 2, (PERMIT G4827) 2630'S. & 1310'W. FROM N.E. COR. SEC. 22

Application No. G-7424

Permit No. G 6834

FINAL PROOF SURVEY
UNDER

G5213
G5292

G4826
G4827

Application No. Permit No.
IN NAME OF

Bar C RANCHES, INC.

Surveyed JULY 30-31 1975, by R.G. MUCKEN...

See next
Page