


G-9166

T 7561
54696
76057
T 7561

T. 34S., R. 19E., W.M.

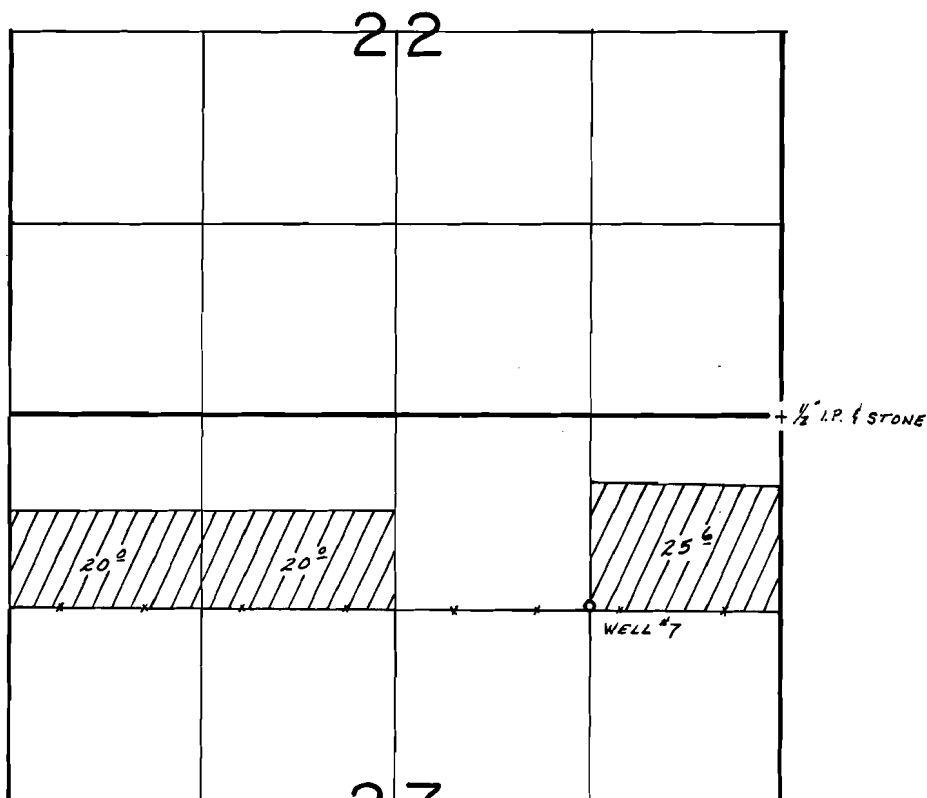

WELL LOC.: 1300 S. & 1310 W. FROM NE COR. SEC. 27.

SCALE: 1" = 1320'

FINAL PROOF SURVEY **UNDER**

See Transfer Map
T-7561

Application No. G-10035 Permit No. G-9166.....
IN NAME OF

.....ADRIAN SOLHEIM.....

Surveyed Oct. 16..... 19.85, by B.W. BISHOP.....