

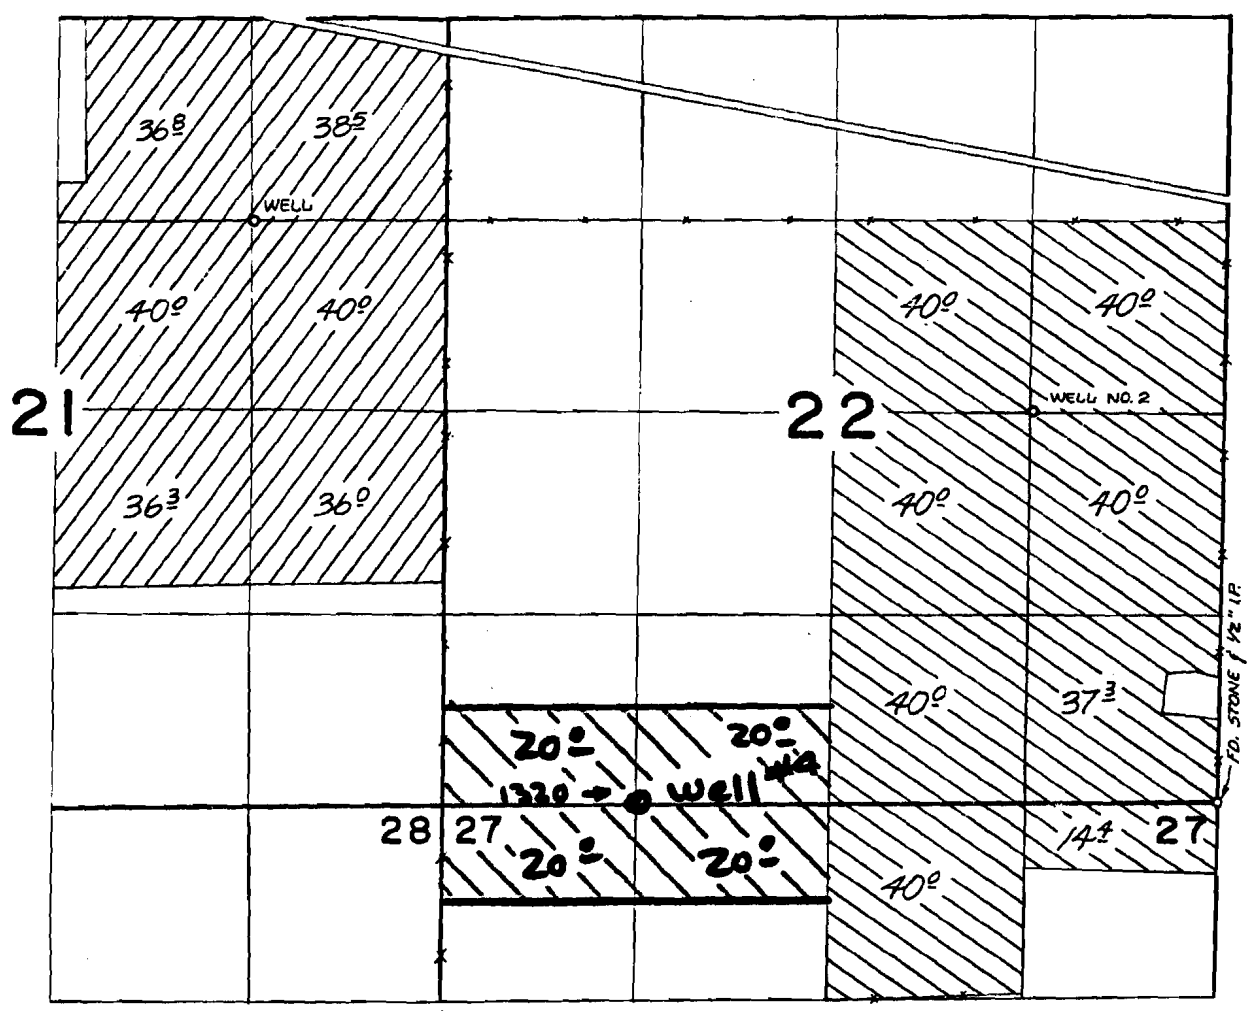
9-702
T-7561
44626
76057

RECEIVED

JUL 1 1976

WATER RESOURCES DEPT.
SALEM, OREGON

T. 34 S. R. 19 E. W. M.

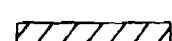
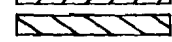


WELL, (PERMIT G4826) 1310'S. & 1330'E. FROM N. 1/4 COR. SEC. 21
WELL NO. 2, (PERMIT G4827) 2630'S. & 1310'W. FROM N.E. COR. SEC. 22

Application No. G-7484

Permit No. G 6834

FINAL PROOF SURVEY
UNDER

 G 5213 G 4826
 G 5292 G 4827

Application No. Permit No.
IN NAME OF

Bar C ~~CSH~~ RANCHES, INC.

Surveyed JULY 30-31 1975, by R.G. MUCKEN....

See Transfer Map
T-7561