


T. 34 S. R. 19 E. W.M.

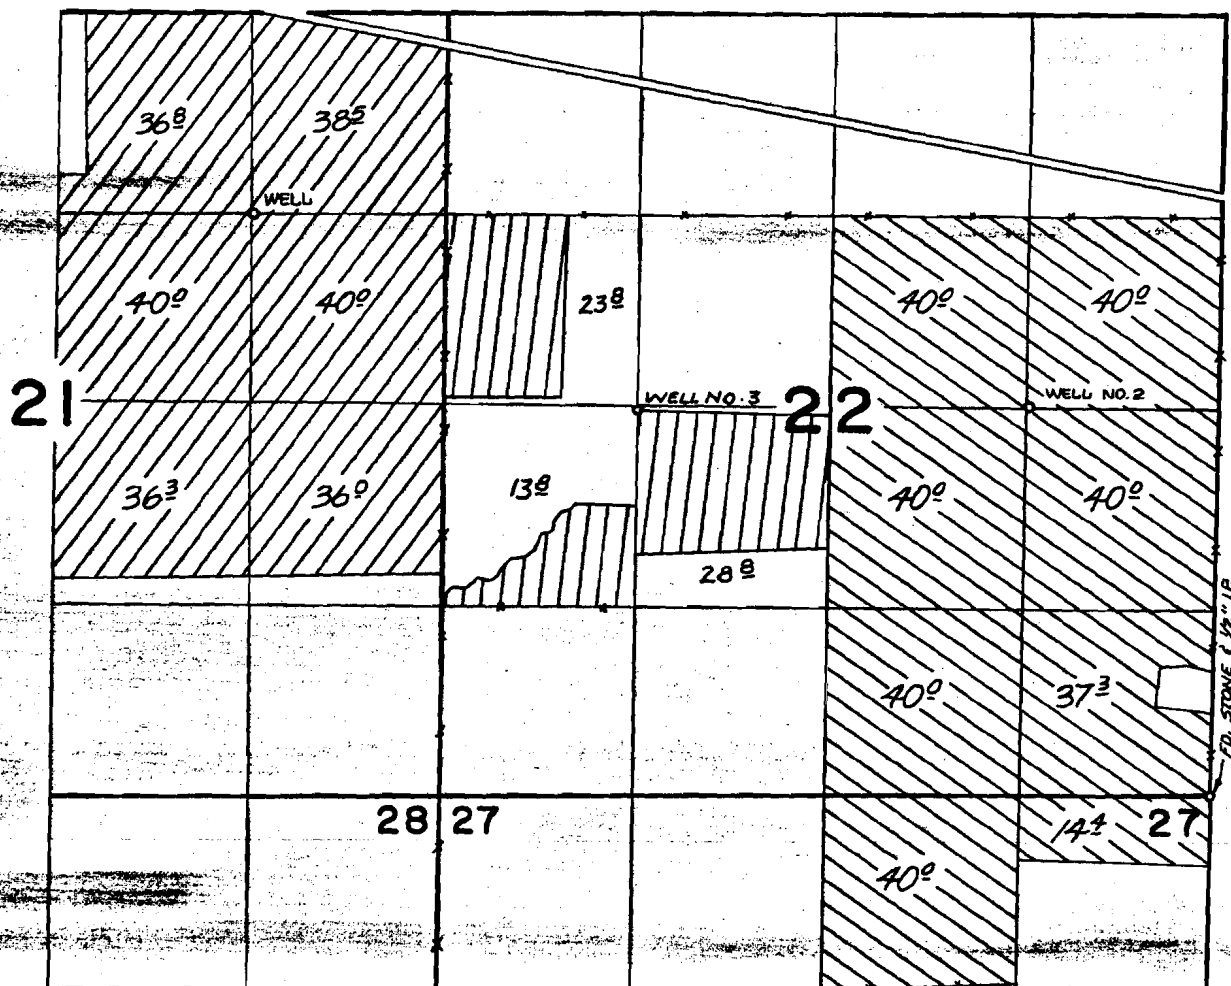

WELL, (PERMIT G-4826) 1310'S. & 1330'E. FROM N. 1/4 COR. SEC. 21
 WELL NO. 2, (PERMIT G-4827) 2630'S. & 1310'W. FROM N.E. COR. SEC. 22
 WELL NO. 3 (PERMIT G-4828) 2720'S. & 1320'E. FROM N.W. COR. SEC. 22

FINAL PROOF SURVEY

UNDER



G 5319
 G 5213
 G 5292

G 4828
 G 4826
 G 4827

Application No. _____ Permit No. _____
 IN NAME OF

BAR C. RANCH

Surveyed JULY 30-31 1975, by R.G. MUCKEN...
 OCT. 25 1976

See Transfer Map
 T-7561