


T15S. R11W., W.M.
NW1/4 - NE 1/4 SECTION 1
LINCOLN COUNTY, OREGON

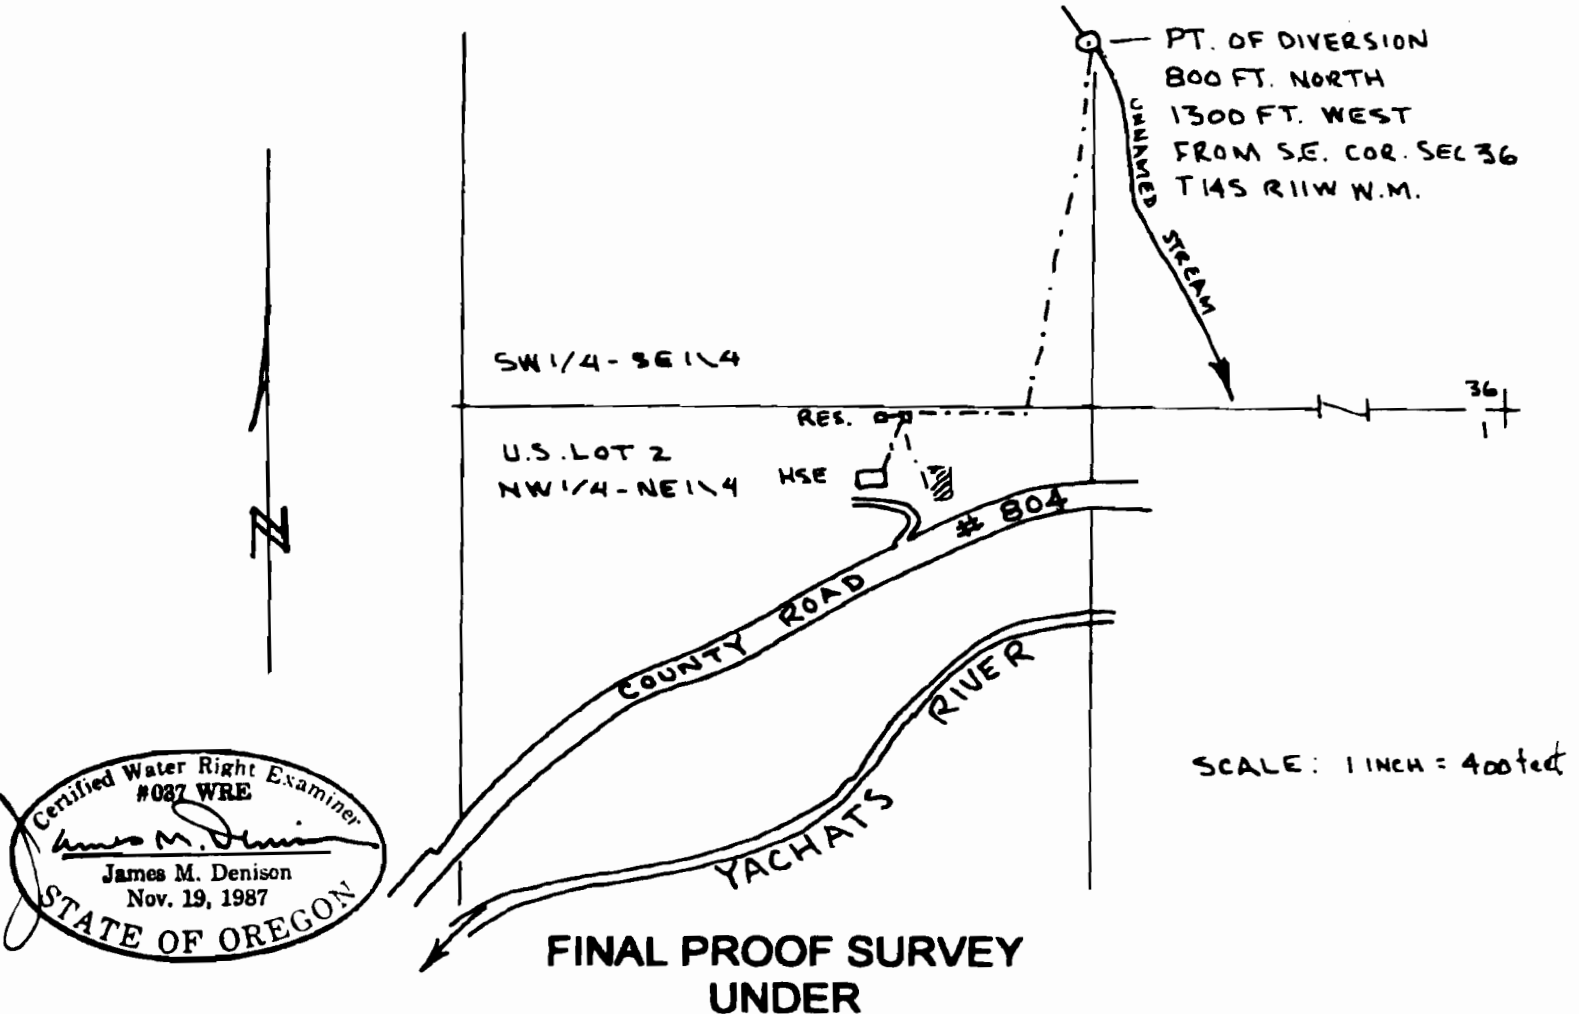

APPLICATION #S73790

PERMIT # 52335

IN THE NAME OF

Jean-Marc Rolland

SURVEYED: SEPTEMBER 04, 1996

BY: J. M. DENISON

THIS MAP PREPARED SOLEY FOR THE PURPOSE OF SHOWING LOCATION OF A WATER RIGHT, AND IS NOT INTENDED FOR USE FOR PROVIDE DIMENSIONS OR LOCATION OF PROPERTY OWNERSHIP LINES.