


SECTION 8, TWP.1 S. RANGE 13 E. W.M.
 WASCO COUNTY, OREGON

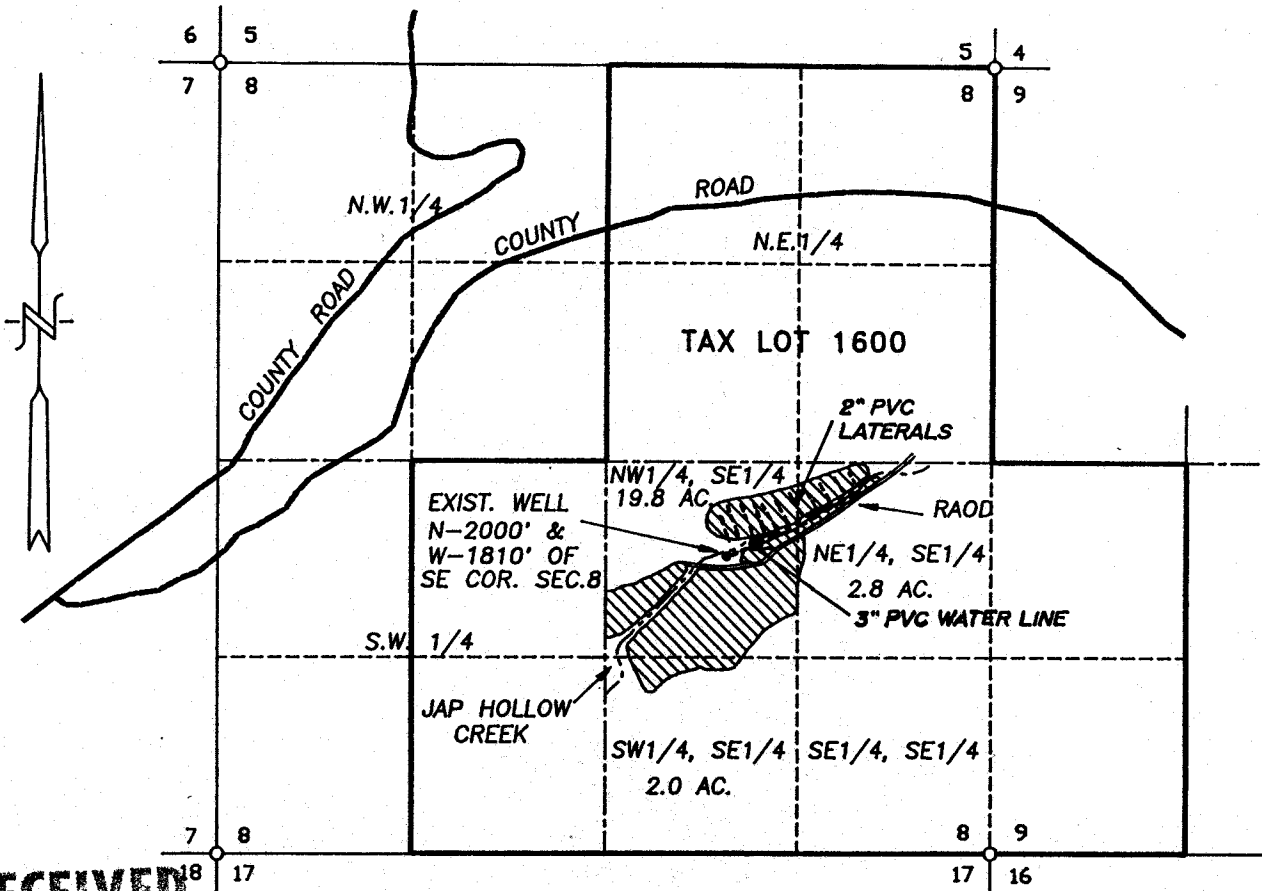

RECEIVED

OCT 23 1995

WATER RESOURCES DEPT.
 SALEM, OREGON

WATER RIGHT

FINAL PROOF SURVEY

SCALE: 1" = 1320'


PERMIT No. G-11037

IN THE NAME OF:

RALPH J. TAYLOR

DATE: SEPTEMBER 30, 1995

BY: TENNESON ENGINEERING CORP.
 409 LINCOLN STREET,
 THE DALLES, OREGON. 97058
 PH. (503) 296-9177
 FAX (503) 296-6657

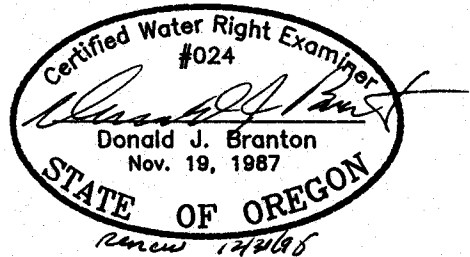

NOTE:

"THIS MAP IDENTIFIES THE LOCATION OF THE WATER RIGHT ONLY AND IS NOT INTENDED TO PROVIDE DIMENSIONS OR LOCATE PROPERTY OWNERSHIP LINES."

W.O. #7028