


Surveyed Aug 8, 1996

T-7006
 CLAIM OF
 BENEFICIAL USE
 for
 U.S. BUREAU OF RECLAMATION

This map is for the purpose of locating a water right only and has no intent to provide legal dimensions or the location of property lines.


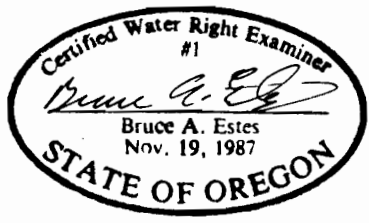


ESTES SURVEYS
 6293 Sunnyview Rd. NE Salem, OR 97305 (503) 585-7593
 60382 Arnold Rd Bend, OR 97702 (503) 382-7391

119 15 To Kennewick

119 00

To Pasco

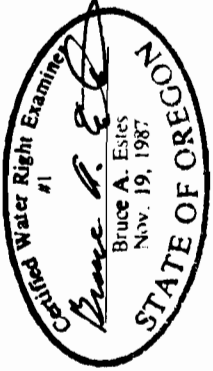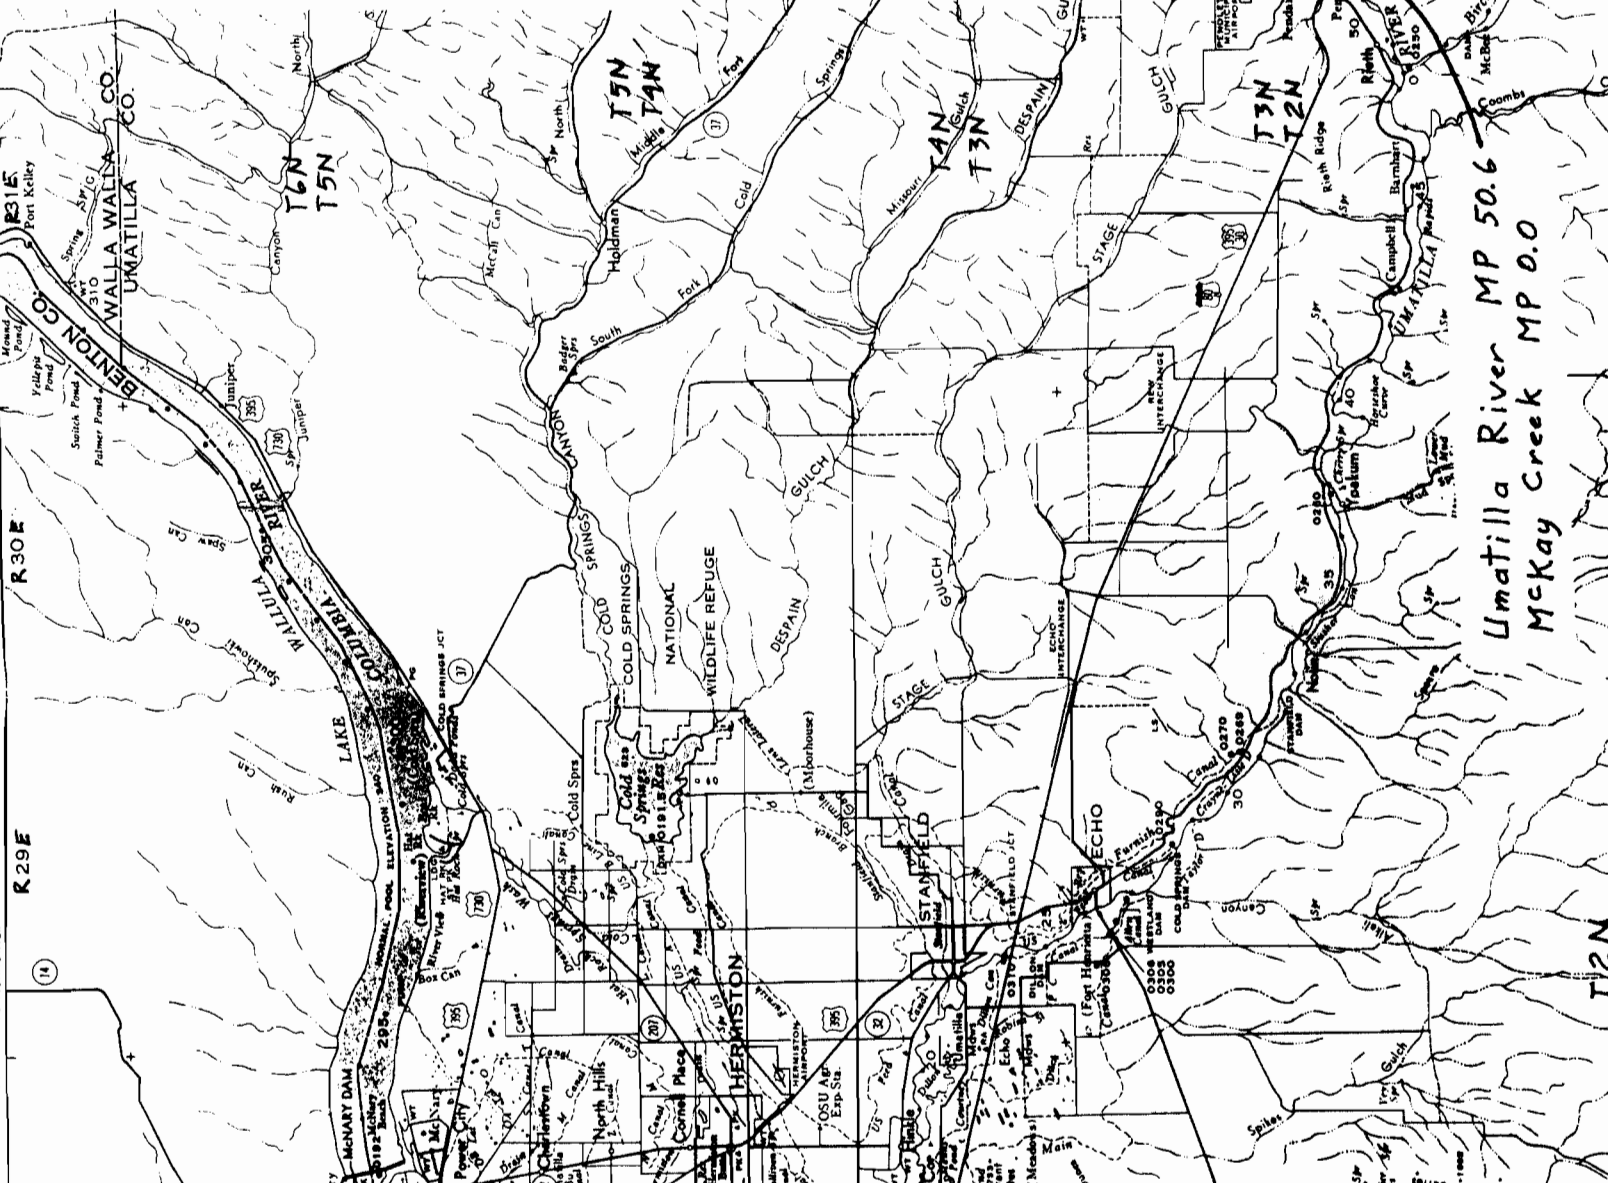

This map is for the purpose of locating a water right only and has no intent to provide legal dimensions or the location of property lines.

ESTES SURVEYS
 6293 Sunnyview Rd. NE 60382 Arnold Rd.
 Salem, OR 97305 Bend, OR 97702
 (503) 585-7593 (503) 382-7391

Surveyed Aug 8, 1996

Scale 1" = 20,000'

Umatilla River MP 50.6
 McKay Creek MP 0.0

MP 61.1