


G-10219
58871
76091

T.26 & 27 S., R.15 E., W.M.

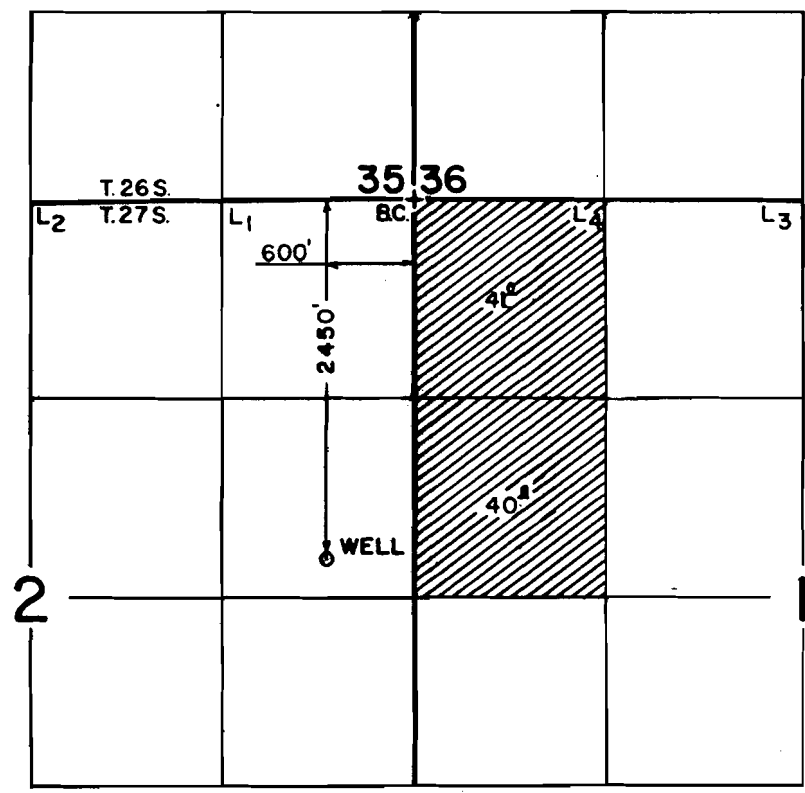

SCALE: 1" = 1320'

FINAL PROOF SURVEY UNDER

Application No. G-11071. Permit No. G-10219...
IN NAME OF

.....GENE PORTER.....

Surveyed .SEPT. 13, 1985., by .T. WARREN.....