


RECEIVED

JAN 16 1998

WATER RESOURCES DEPT.
SALEM, OREGON


NW 1/4 OF SW 1/4 OF SECTION 4
SW 1/4 OF SW 1/4 OF SECTION 4
NW 1/4 OF NW 1/4 OF SECTION 9
T4S, R4E of WM
CLACKAMAS COUNTY, OREGON

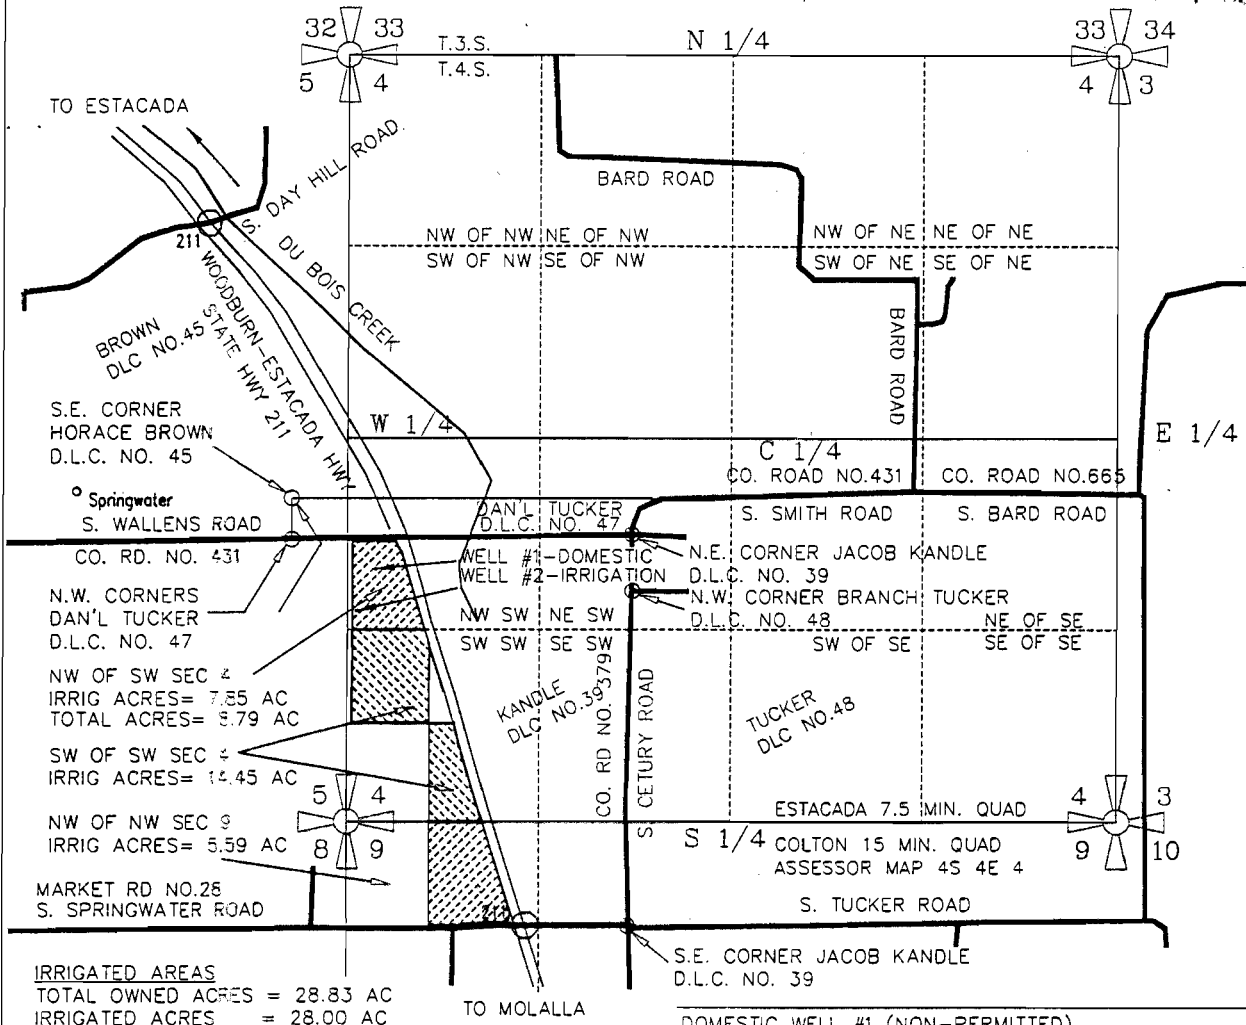

IRRIGATED AREAS
TOTAL OWNED ACRES = 28.83 AC
IRRIGATED ACRES = 28.00 AC


DOMESTIC WELL #1 (NON-PERMITTED)
WELL #1 IS LOCATED 228 FEET SOUTH AND 702 FEET EAST OF THE SOUTHEAST CORNER OF HORACE BROWN D.L.C. NO. 45 IN SEC. 4 TOWNSHIP 4 SOUTH, RANGE 4 EAST OF WM, CLACKAMAS COUNTY, OR.

IRRIGATION WELL #2 (PERMITTED)
WELL #2 IS LOCATED 515 FEET SOUTH AND 472 FEET EAST OF THE SOUTHEAST CORNER OF HORACE BROWN D.L.C. NO. 45 IN SEC. 4 TOWNSHIP 4 SOUTH, RANGE 4 EAST OF WM, CLACKAMAS COUNTY, OR.

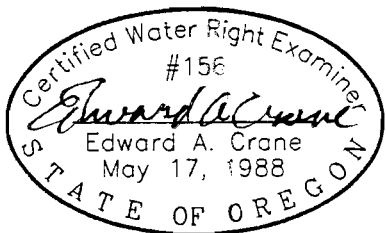


Renewal 12/31/99
Signed 12-30-98

SURVEYED APR. 10, 1998
BY EDWARD A. CRANE, CWRE

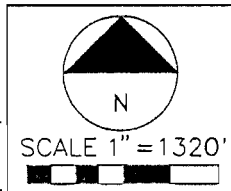

PREPARATION OF THIS MAP WAS FOR THE PURPOSE OF IDENTIFYING THE LOCATION OF THE WATER RIGHTS ONLY AND HAS NO INTENT TO PROVIDE DIMENSIONS OR LOCATION OF PROPERTY OWNERSHIP LINES.

FINAL PROOF SURVEY
GROUNDWATER PERMIT G-11999
PREPARED BY EDWARD A. CRANE, CWRE

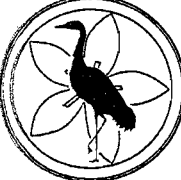DATE APR. 1998 DEC. 1998 PROJECT NO. 287-001	 CRANE & MERSETH Engineering/Surveying SUITE "D" 6566 SE LAKE ROAD MILWAUKIE, OREGON 97222 BUS: (503) 654-2005 FAX: (503) 654-2575	APPLICATION FOR PERMIT NUMBER <u>G-12666</u> PERMIT NUMBER <u>G-11999</u> IN THE NAME OF: CHERYL A. ALEXANDER & VICKI L. McKEE dba A.M. NURSERY, TEL: 503-630-5111, 26046 S. WALLENS ROAD, ESTACADA, OR 97023	SHEET 1/1
--	---	---	---------------------------