


6-11753  
76096

T.39S.,R7E.,W.M.  
SECTION 25

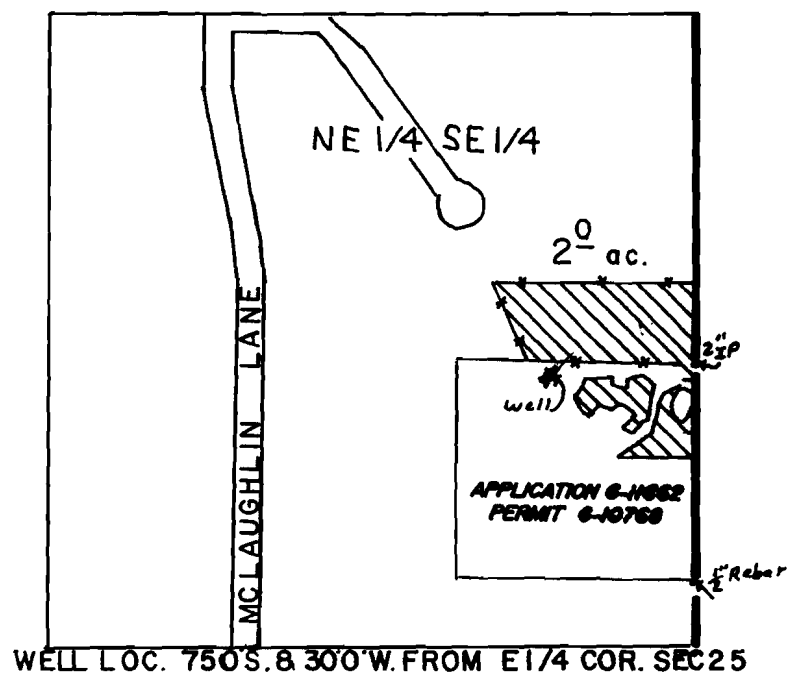

Klamath Riv. Wells

WELL LOC. 750'S. & 300'W. FROM E1/4 COR. SEC 25

SCALE: 1" = 400'



APPLICATION MAP

FOR Application No. G-13463  
Permit No. G11753

DELBERT & NORANNE SPARKS

THE PURPOSE OF THIS MAP IS TO IDENTIFY THE LOCATION OF THE WATER RIGHT. IT IS NOT INTENDED TO PROVIDE INFORMATION RELATIVE TO THE LOCATION OF PROPERTY OWNERSHIP BOUNDARY LINES.