

CLAIM OF BENEFICIAL USE MAP

Application NO. 72432; Permit NO. 52595

Township 33 South, Range 5 West, Section 29, Willamette Meridian

Point of Diversion within the SE 1/4 of NE 1/4 of SE 1/4, Section 29

Point of use within the NE 1/4 of NE 1/4 of SE 1/4, Section 29

RECEIVED


MAY 26 1998

WATER RESOURCES DEPT.
SALEM, OREGON

Surveyed: March 7, 1998: The purpose of this map is to identify the location of the water right and is not intended to provide dimensions or location of property ownership lines.

Prepared by: Philip B. Wickham
P.O. Box 564
Grants Pass, OR. 97528

Date: March 18, 1998

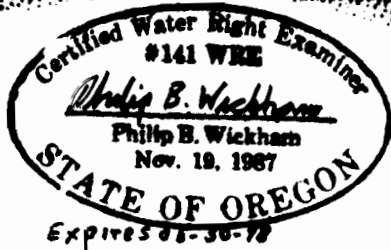

E/W, 660' approximately

29 28

NE 1/4 OF NE 1/4 OF SE 1/4 Section 29 Tax Lot 407

1/4 Corner
Section 29/28




Scale 1" = 100'

N/S, 660' approximately

S.E. 1/4

POINT OF USE (Domestic)
210' N. & 290' W. of
S.E. Property Corner

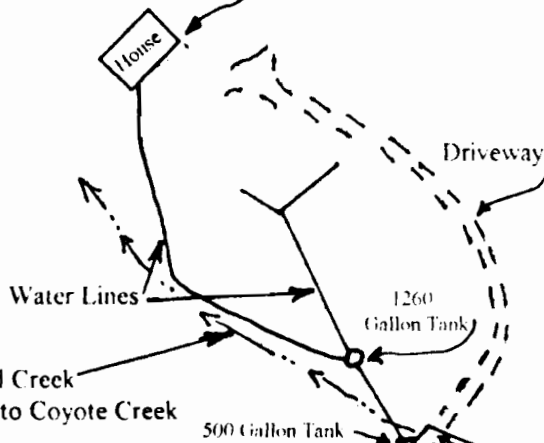

S.E. Property Corner
Found 5/8" Iron Rod with 1 1/2" aluminum cap
stamped R.P.L.S. 2429, Por CS NO 7392

N. 0° 09' 00" E. 661.92'

E/W, 660' approximately

Prepared for: George Withers
P.O. Box 144
Wolf Creek, OR 97497
Property Address: 3751 Coyote Creek Road

SE 1/4 of NE 1/4 of SE 1/4 Tax Lot 409
POINT OF DIVERSION
catch basin/dam S. 0° 09' W., 43.2' and
N. 89° 51' W. 34.6' from SE Property Corner