

CLAIM OF BENEFICIAL USE FINAL PROOF MAP


Located in the NW¼ NE¼ of Section 9
Township 23 South, Range 12 West, W.M.
Coos County, Oregon
Application S-80986 Permit 53095

Scale 1" = 400 Feet

Prepared For: Lewis & Beverly Paulson
Prepared By: Dennis Goude
Date Prepared: September 15, 1998

NOTE:
The P.O.D. is a 1/2 HP pump
located 1332 feet North and
280 feet East of the C1/4
corner of Section 9.


LEGEND
P.O.B. 
P.O.D. 

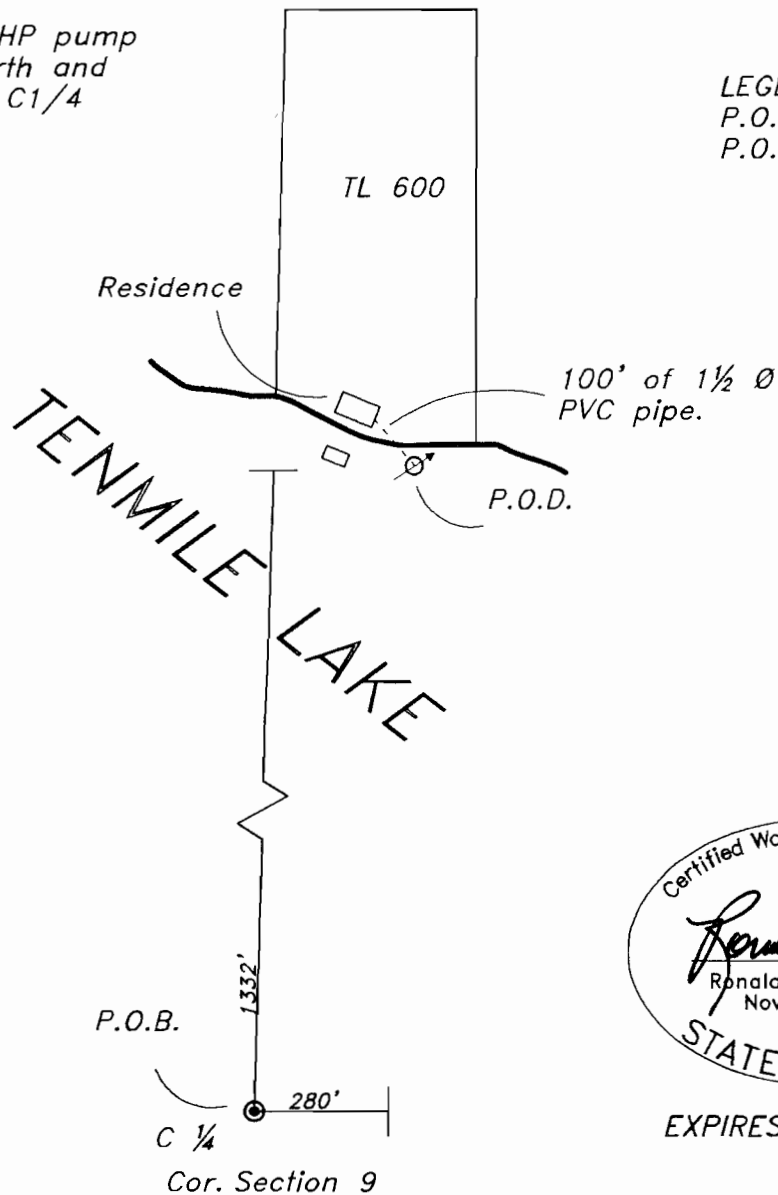

RECEIVED

OCT 23 1998

WATER RESOURCES DEPT.
SALEM, OREGON

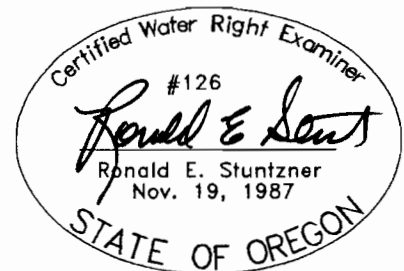

EXPIRES 06/30/00

EXAMINERS DISCLAIMER STATEMENT

The preparation of this map was for the purpose of identifying the location of the Water Right only and has no intent to provide dimensions or location of property ownership lines.

**Stuntzner Engineering
& Forestry, L.L.C.**

ENGINEERING • LAND SURVEYING • FORESTRY
PLANNING • WATER RIGHTS

705 South 4th St.
Post Office Box 118
Coos Bay, Oregon 97420

Phone: (541) 267-2872
Fax: (541) 267-0588