


T. 35 S., R. 6 W., W. M.

Sec. 11

SE 1/4 SW 1/4

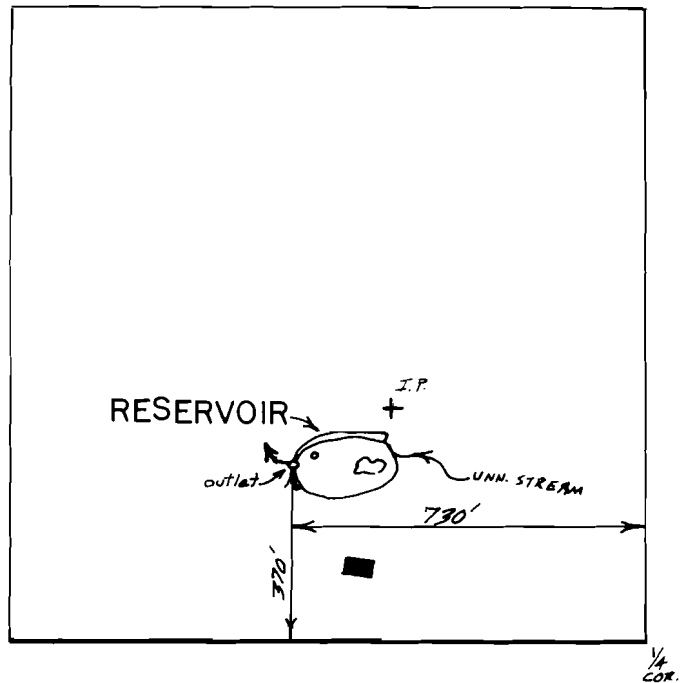

Scale 1" = 400'

FINAL PROOF SURVEY
UNDER

Application No. R-81379 Permit No. R-12199...
IN NAME OF

.....PATRICIA HENDRIX.....

Surveyed June 16, 1998, by BR. SUND, N. DAFT.