
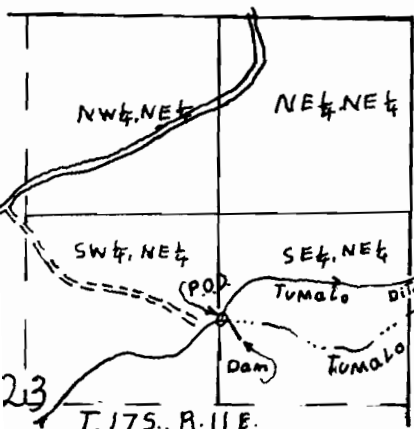


T.16,17S.,R.11E.,W.M.

RECEIVED

OCT 05 1998

WATER RESOURCES DEPT.
SALEM, OREGON

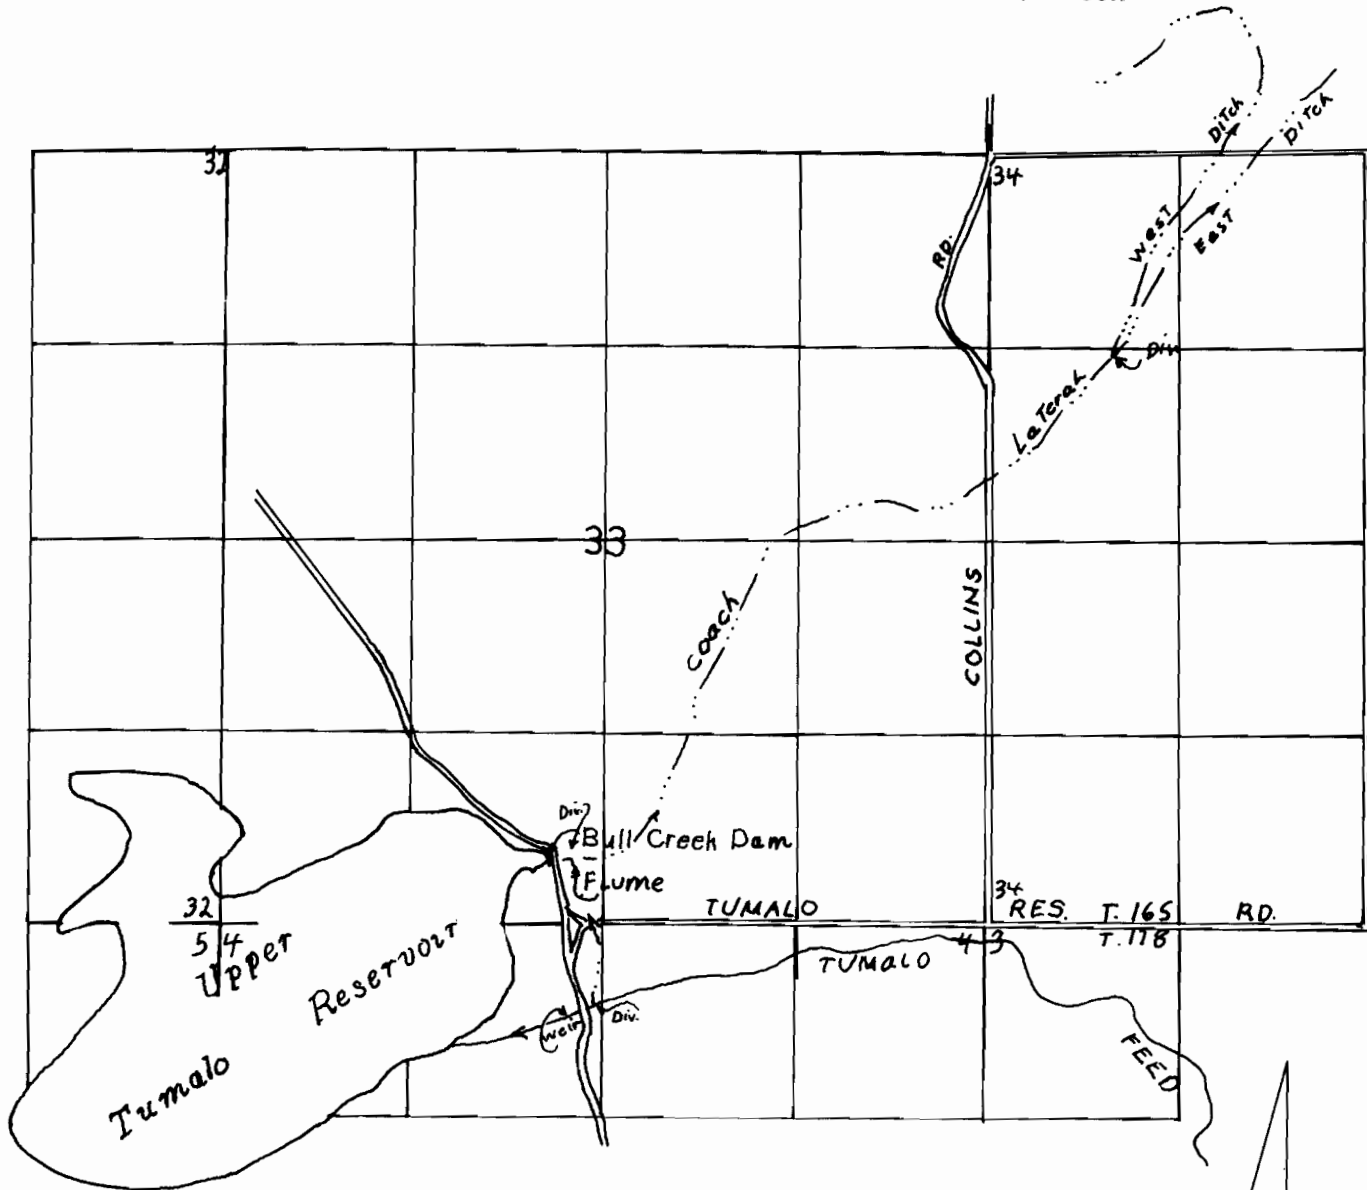

FINAL PROOF SURVEY UNDER

Application No. R-37238 Permit No. R-2743
IN NAME OF

TUMALO IRRIGATION DISTRICT

Surveyed AUG.26. 1998, by R.M.SUTTERFIELD



DIV. PT. 2080'S & 1310'W FROM
NE COR. OF SEC. 23.