


# T. 4 N. R. 29 E. W. M.

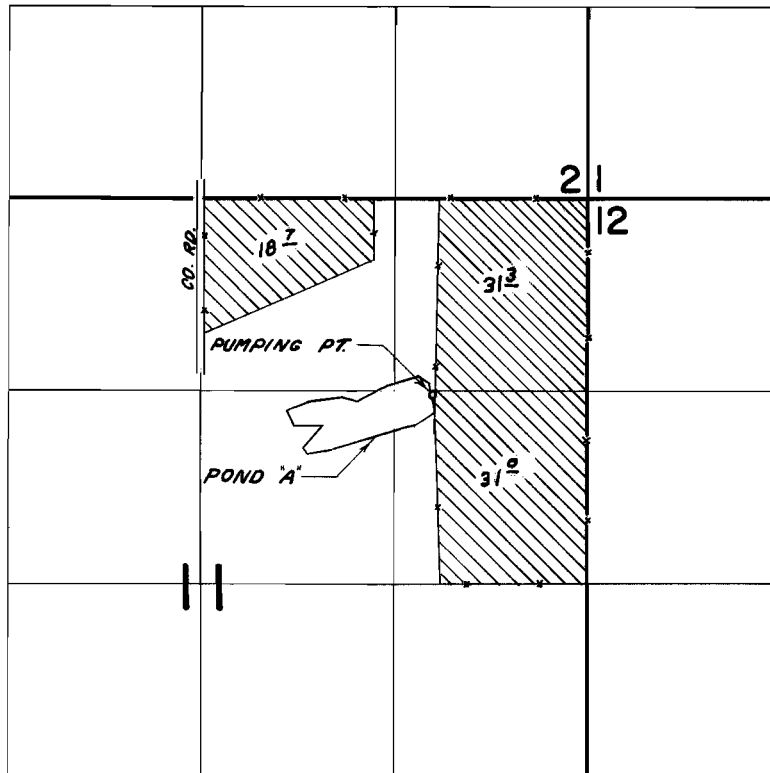

DIV. PT. LOC. 1340' S. & 1060' W. FROM NE. COR. SEC. 11

## FINAL PROOF SURVEY UNDER

Application No. 40471... Permit No. 30267...  
IN NAME OF

..... L. M. GOSSLER .....

Surveyed AUG. 28, 1971., by L. E. GOULD.