


T. 4N. R. 29E. W.M.

SECTION 13

CO. RD.

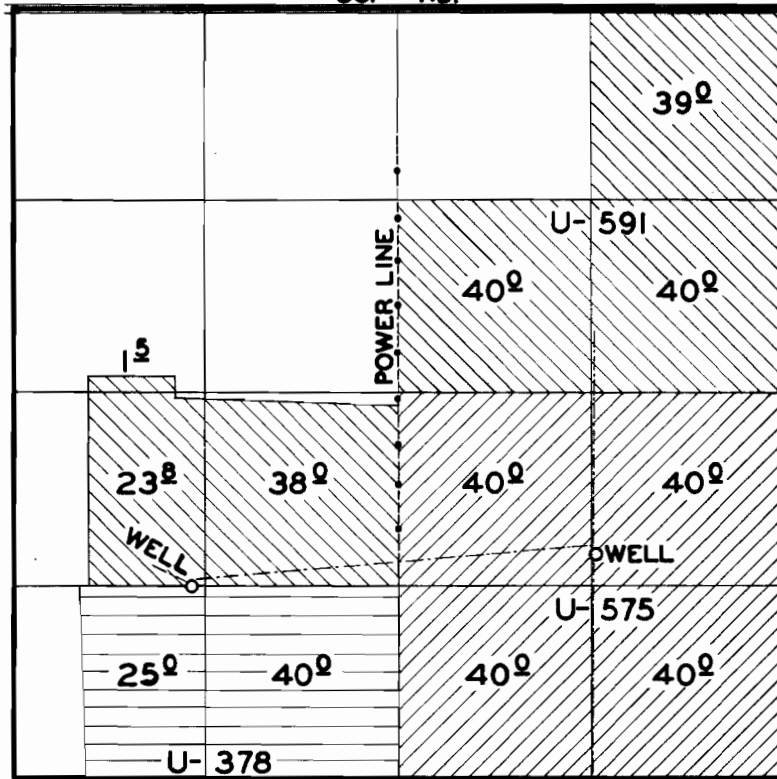

FINAL PROOF SURVEY

U- 643 U- 591
U- 622 U- 575
Application No. U- 408 Permit No. U- 378

IN NAME OF

EDWARDS FARMS INC.

Surveyed MAY 11, 1957, by *C.O. Bartels*