


T 4 N. R. 29 E. W. M.

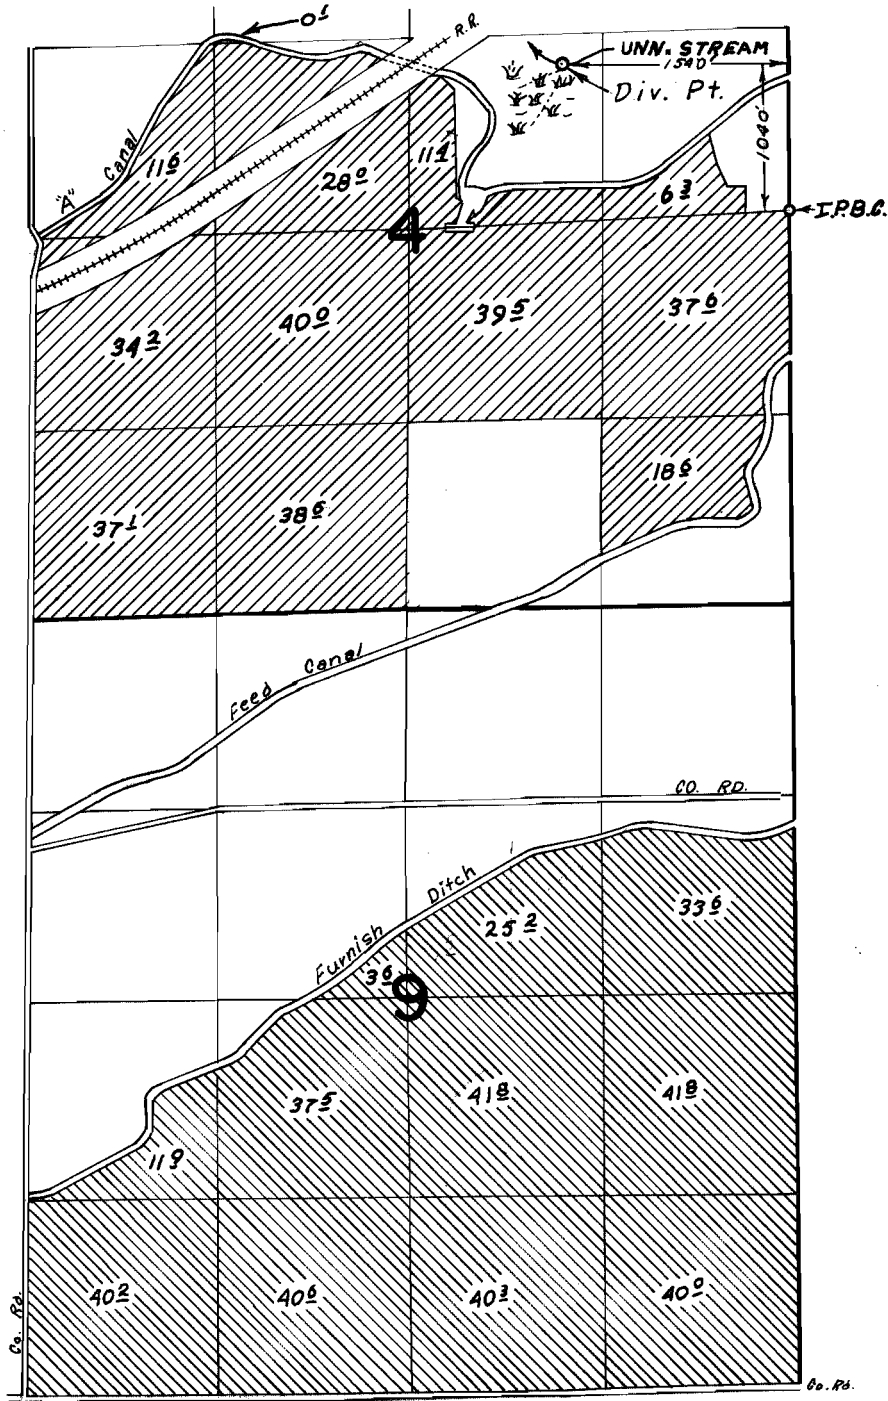

FINAL PROOF SURVEY UNDER



SUPPLEMENTAL

PRIMARY

Application No. 40535 Permit No. 30373
IN NAME OF

JOHN F. WALCHLI

Surveyed AUG. 30. 1971., by L. E. Gould