


T. 4N., R. 29E., W. M.

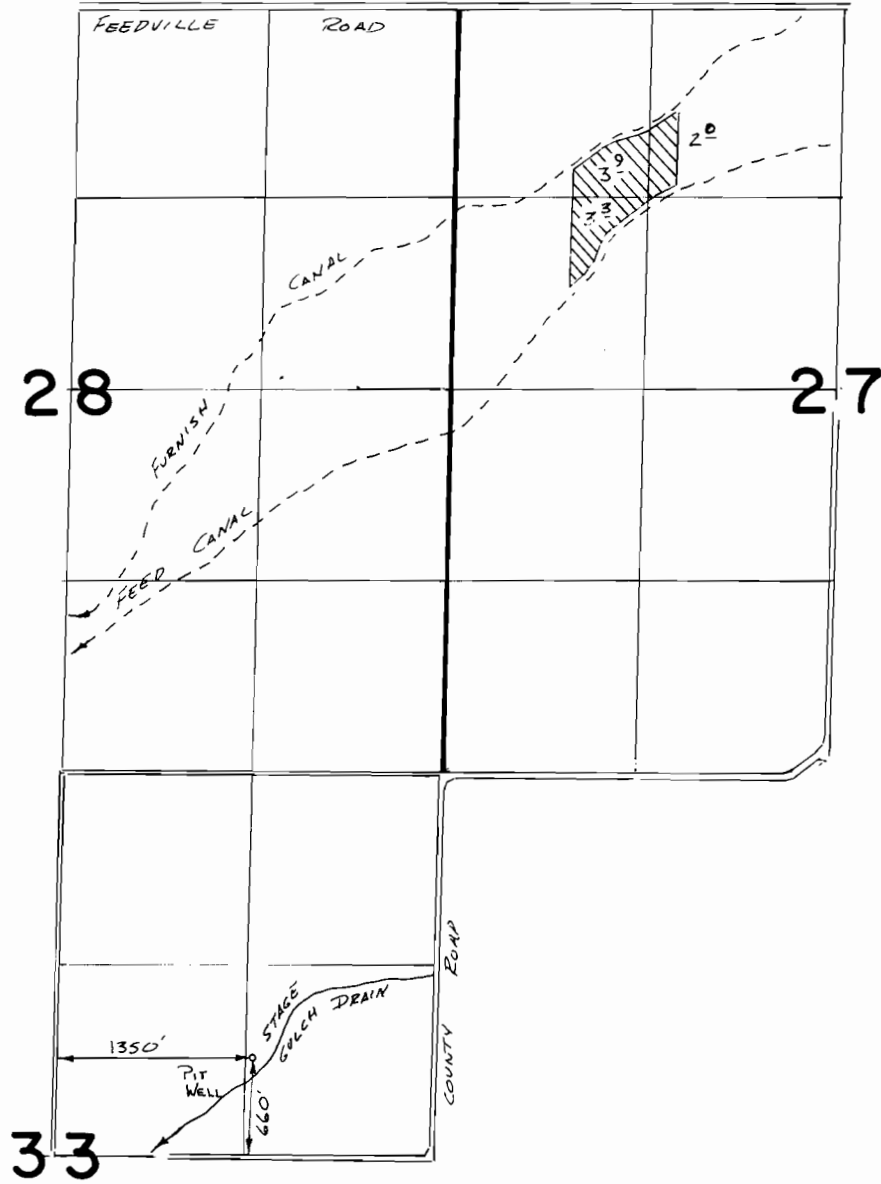

SCALE 1" = 1320'

**FINAL PROOF SURVEY**  
UNDER

Application No. **G:11433** Permit No. **G:10587**  
IN NAME OF

**DON MILLS**

Surveyed ..9..4..... 1987., by *V. L. Church*.....