



T. 4N., R. 29E., W. M.

*Pumped from A*

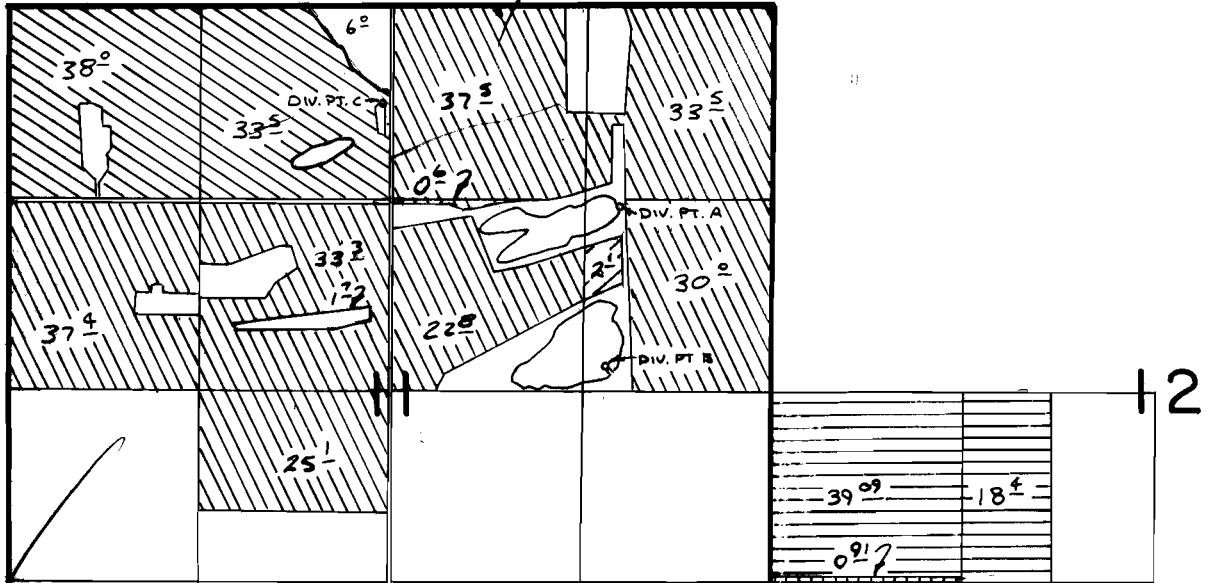

DIV. PT. A LOCATED 1300'S & 1050'W. FROM NE COR. SEC 11 T.4N. R.29E.  
 DIV. PT. B LOCATED 8470'S & 1140'W. FROM NE. COR SEC 11 T.4N. R.29E.  
 DIV. PT. C LOCATED 660'S & 2690'W FROM NE COR. SEC 11 T.4N. R.29E.

*Not from ponds @ all*

-  SUPPL "A" & "B"
-  SUPPL "B"  
PRIM "B"
-  PRIM "A"  
SUPPL "B"
-  SUPPL "C"

**FINAL PROOF SURVEY**  
 UNDER

Application No. **56083** Permit No. **44378**  
 IN NAME OF

Surveyed 8-28 1981 by V.L. Church