


T. 4N., R. 29E., W. M.

Pumped from A

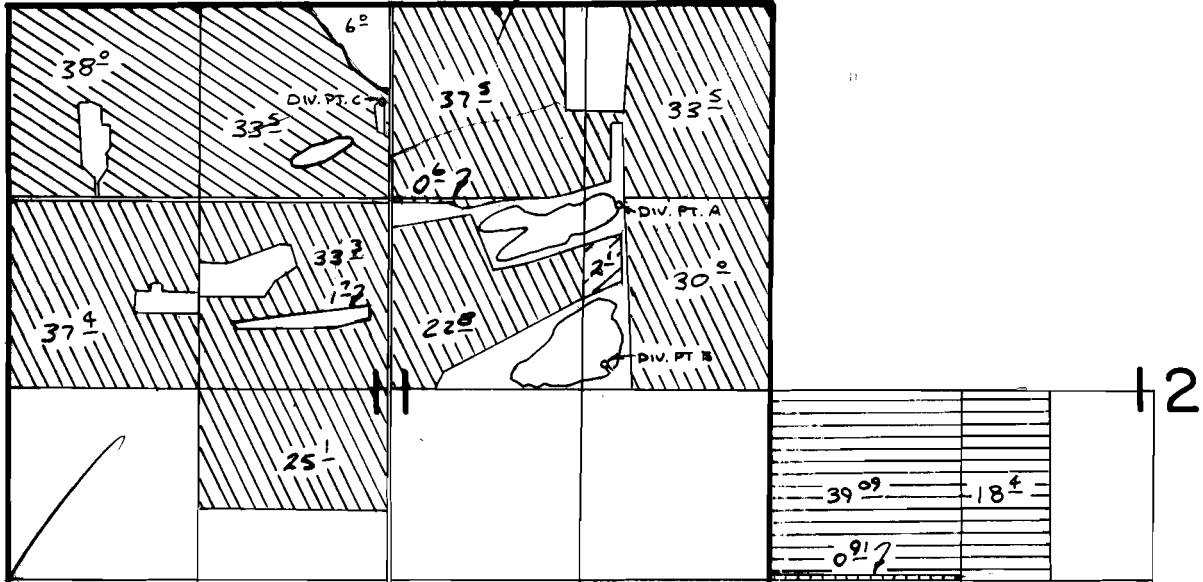

DIV. PT. A LOCATED 1300'S & 1050' W. FROM NE COR. SEC 11 T.4N. R.29E.
 DIV. PT. B LOCATED 2470'S & 1140' W. FROM NE COR. SEC 11 T.4N. R.29E.
 DIV. PT. C LOCATED 660'S & 2690' W. FROM NE COR. SEC 11 T.4N. R.29E.

Net from ponds @ all

-  SUPP'L "A" & "B"
-  SUPP'L "B"
PRIM "B"
-  PRIM "A"
SUPP'L "B"
-  SUPP'L "C"

FINAL PROOF SURVEY
 UNDER

Application No. 56083 Permit No. 44378
 IN NAME OF

Surveyed 8-28 1981 by V.P. Church