

Sec. 24 T. 6 S. R. 4 W.

Permit No. 4796, C.M. Purvine, May 22, 1928.


 Permit No. 4796

R-30829
 30830

4
 1928
 1928
 1928

Township 6 E,

Range 4 W.

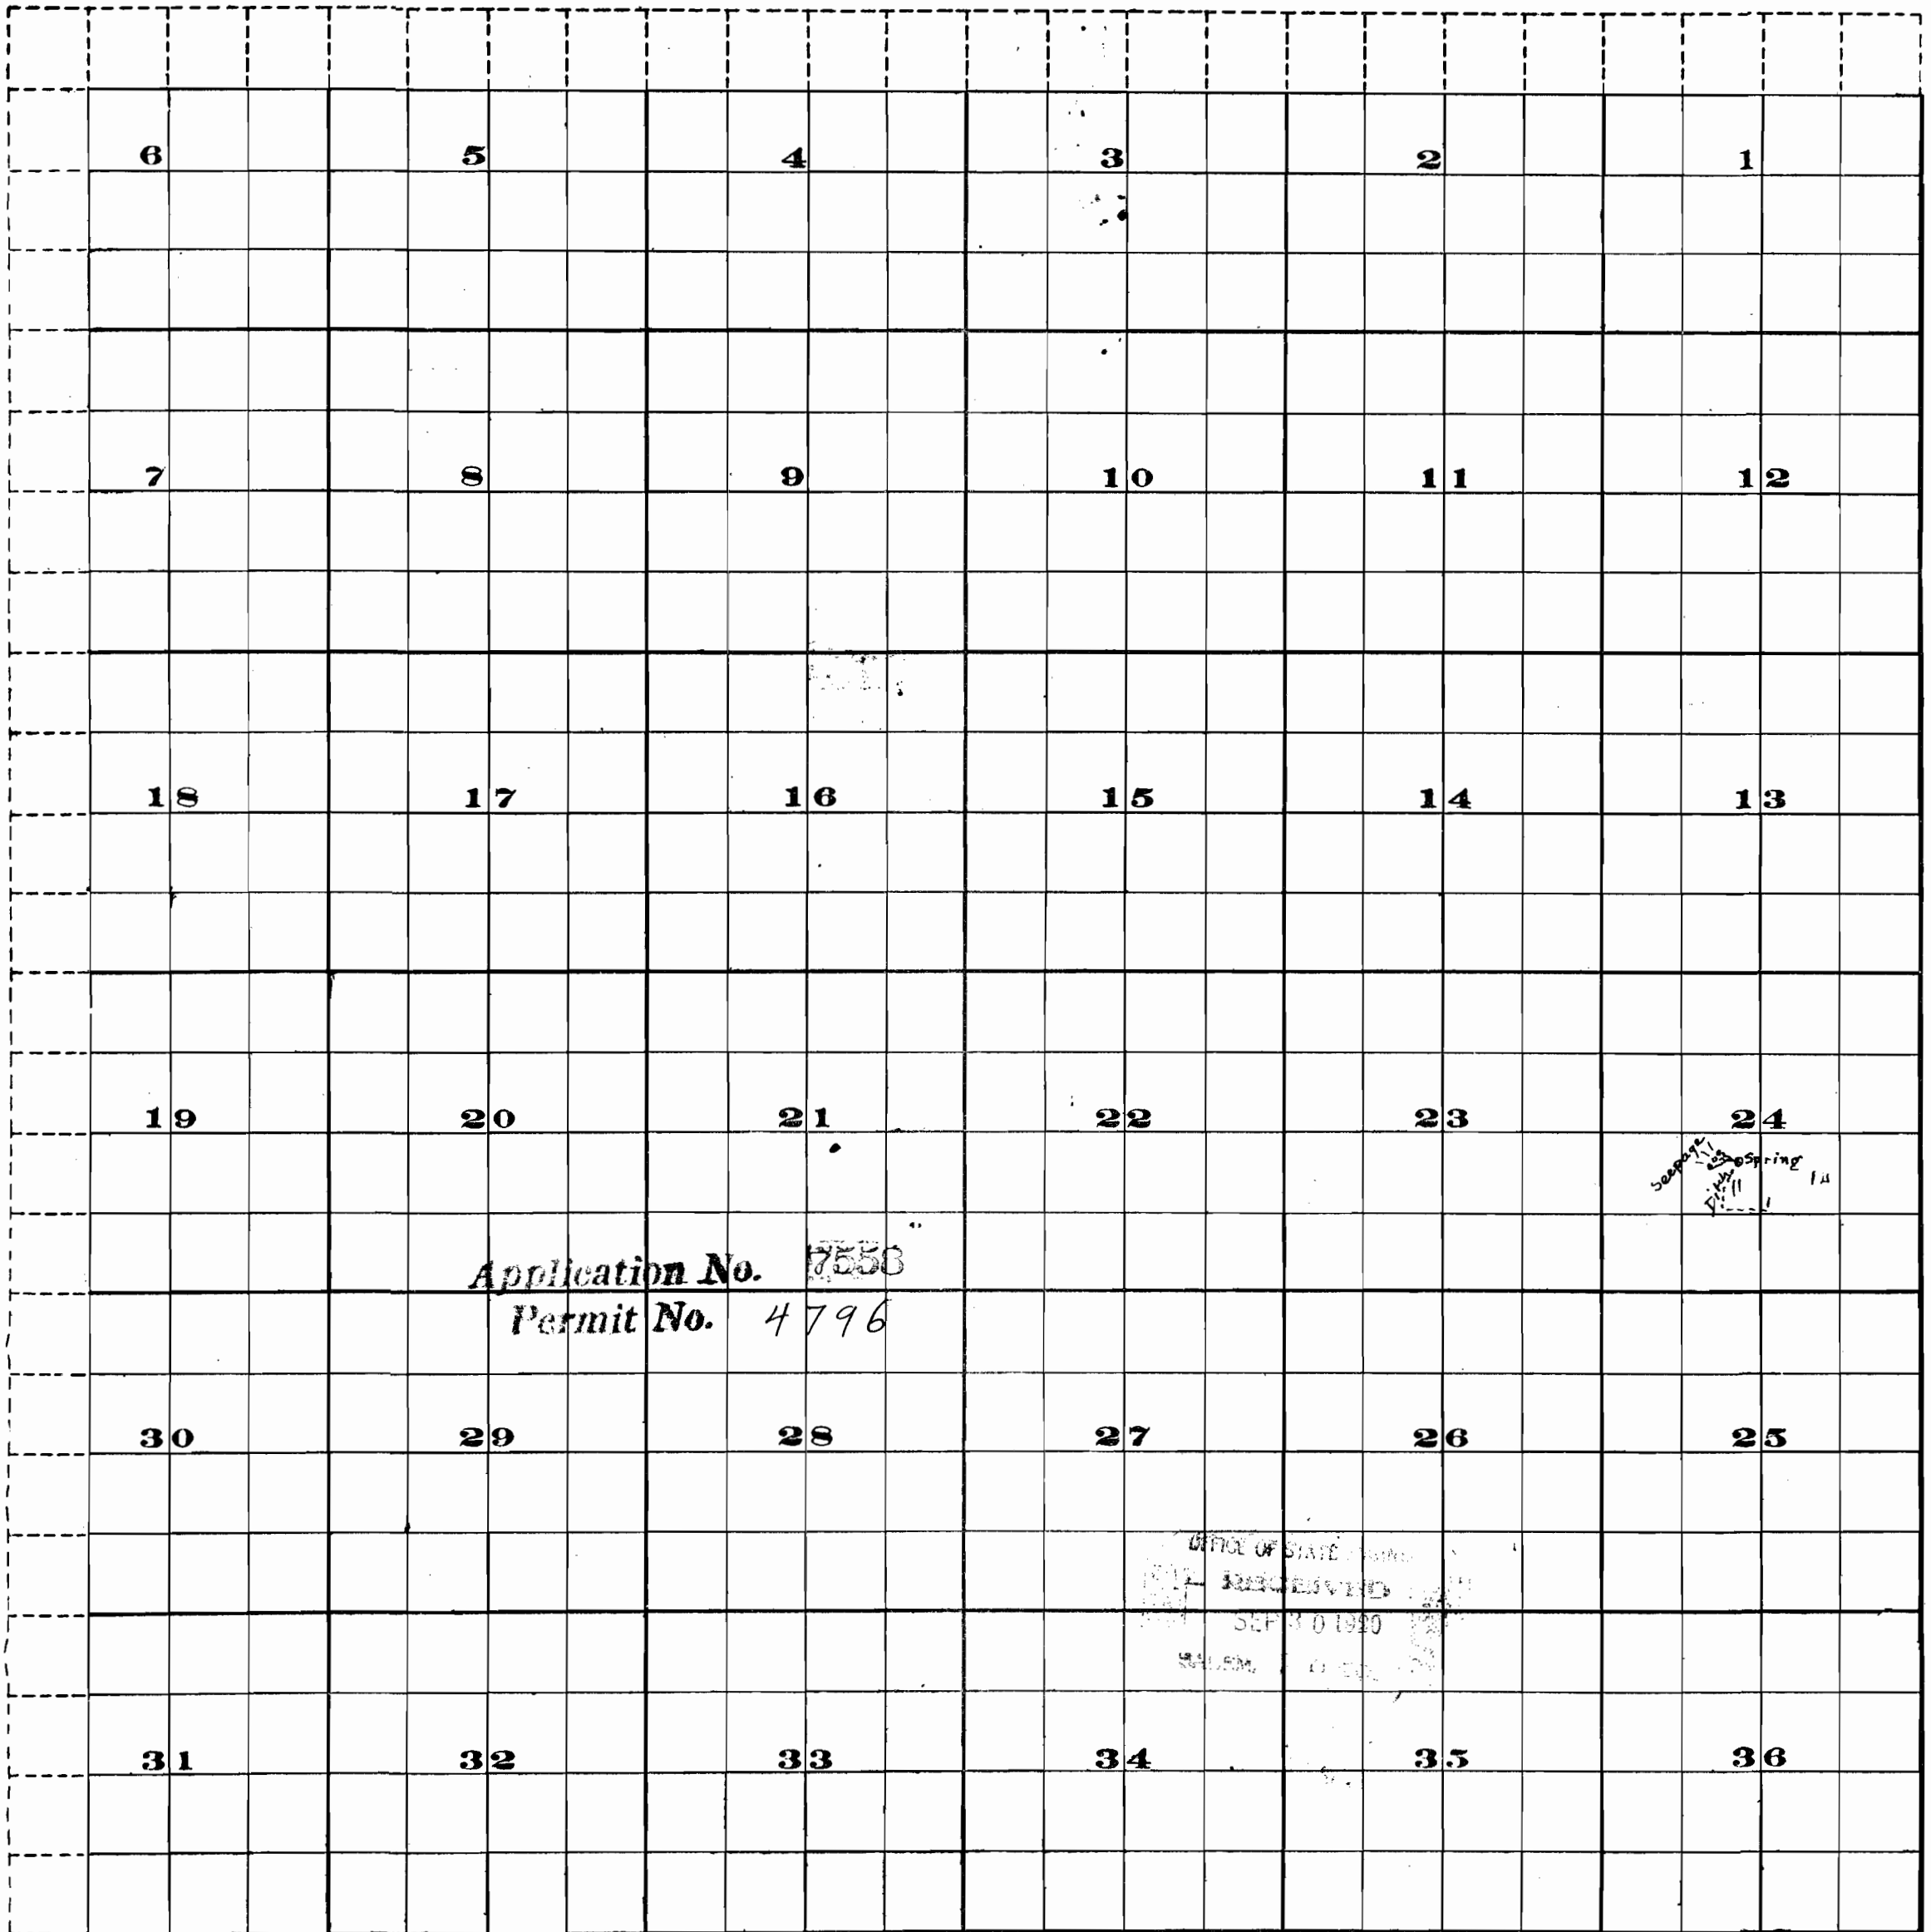

2-2-22

0591.03 X 1/2 B

1202