


T. 8 S., R. 5 W., W.M.

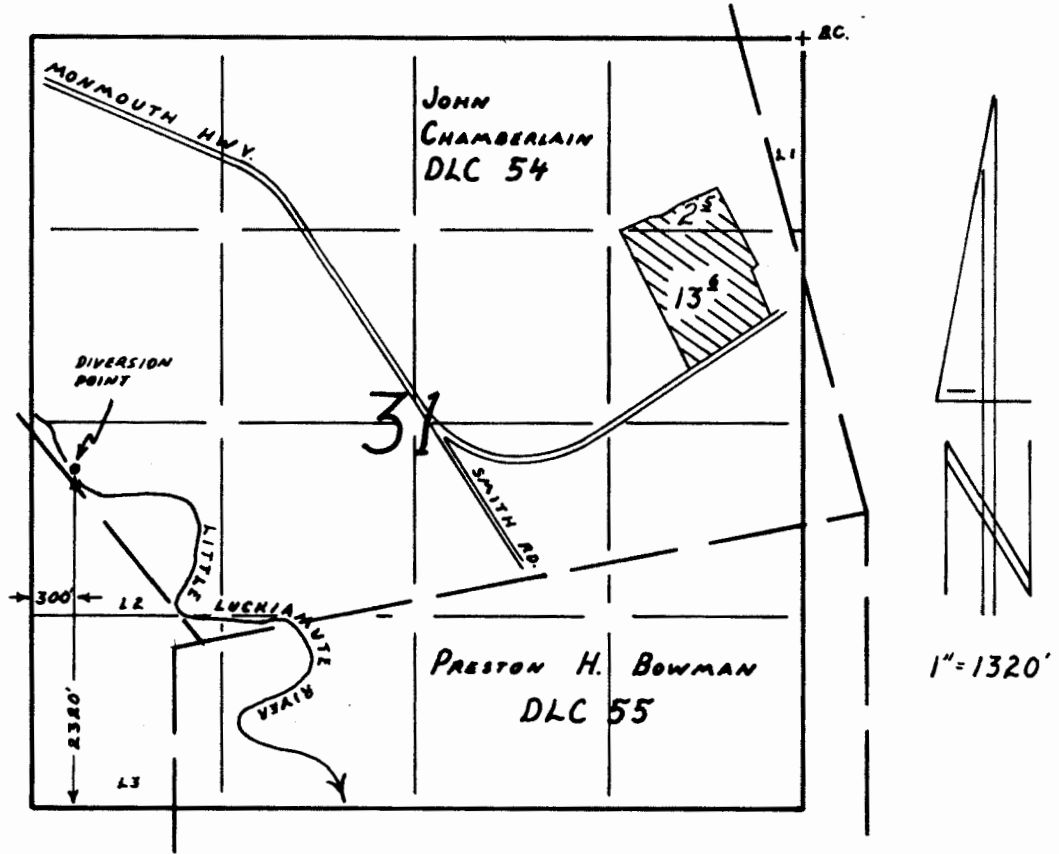

FINAL PROOF SURVEY

UNDER

Application No. 69152 Permit No. 50082
IN NAME OF

HIGHLAND TREE FARMS, INC.

Surveyed June 23, 1993, by R.W. Klassen