


# T.23S.,R.7W.,W.M.

SCALE 1" = 1320'

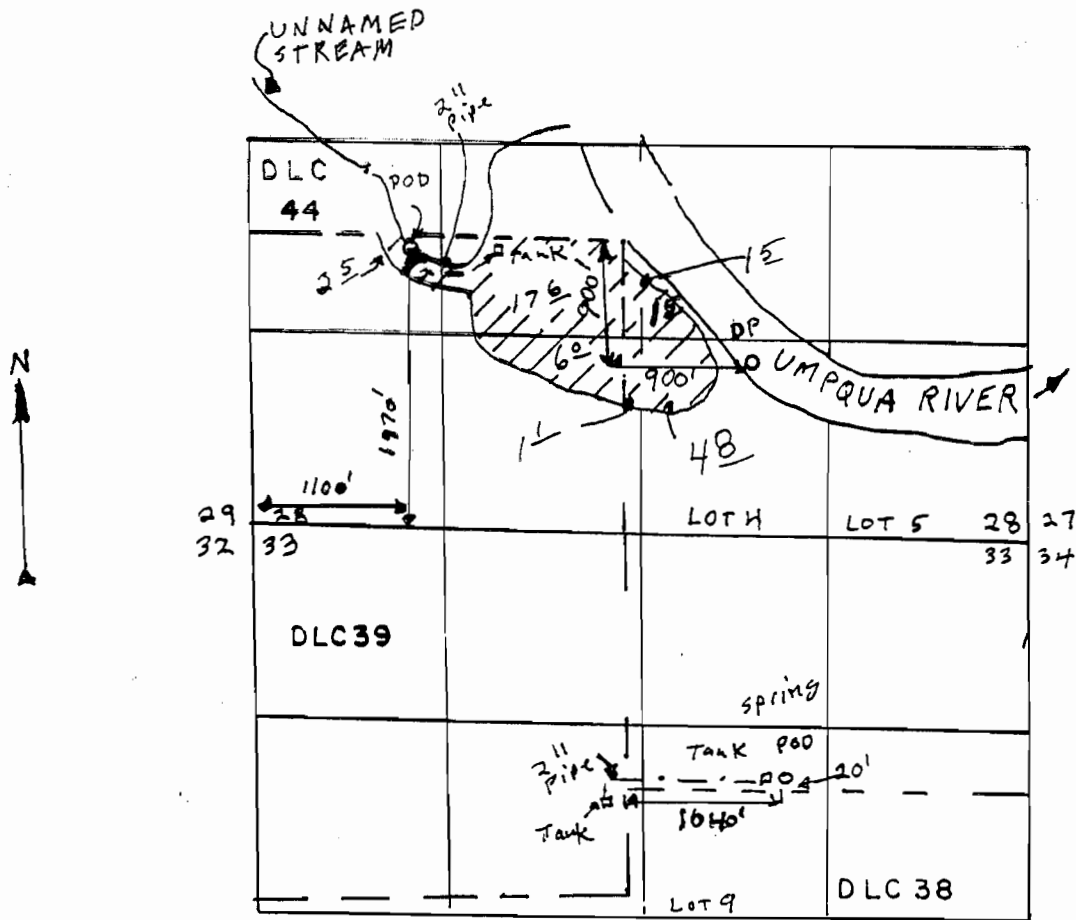

## FINAL PROOF SURVEY

UNDER

THE PURPOSE OF THIS MAP IS TO IDENTIFY THE LOCATION OF THE WATER RIGHT. IT IS NOT INTENDED TO PROVIDE INFORMATION RELATIVE TO THE LOCATION OF PROPERTY OWNERSHIP BOUNDARY LINES.

Application No. 71824 Permit No. 51447

IN NAME OF

DARRYL C. RAY

Surveyed AUG 25 1995 by DUANE KIRBY

