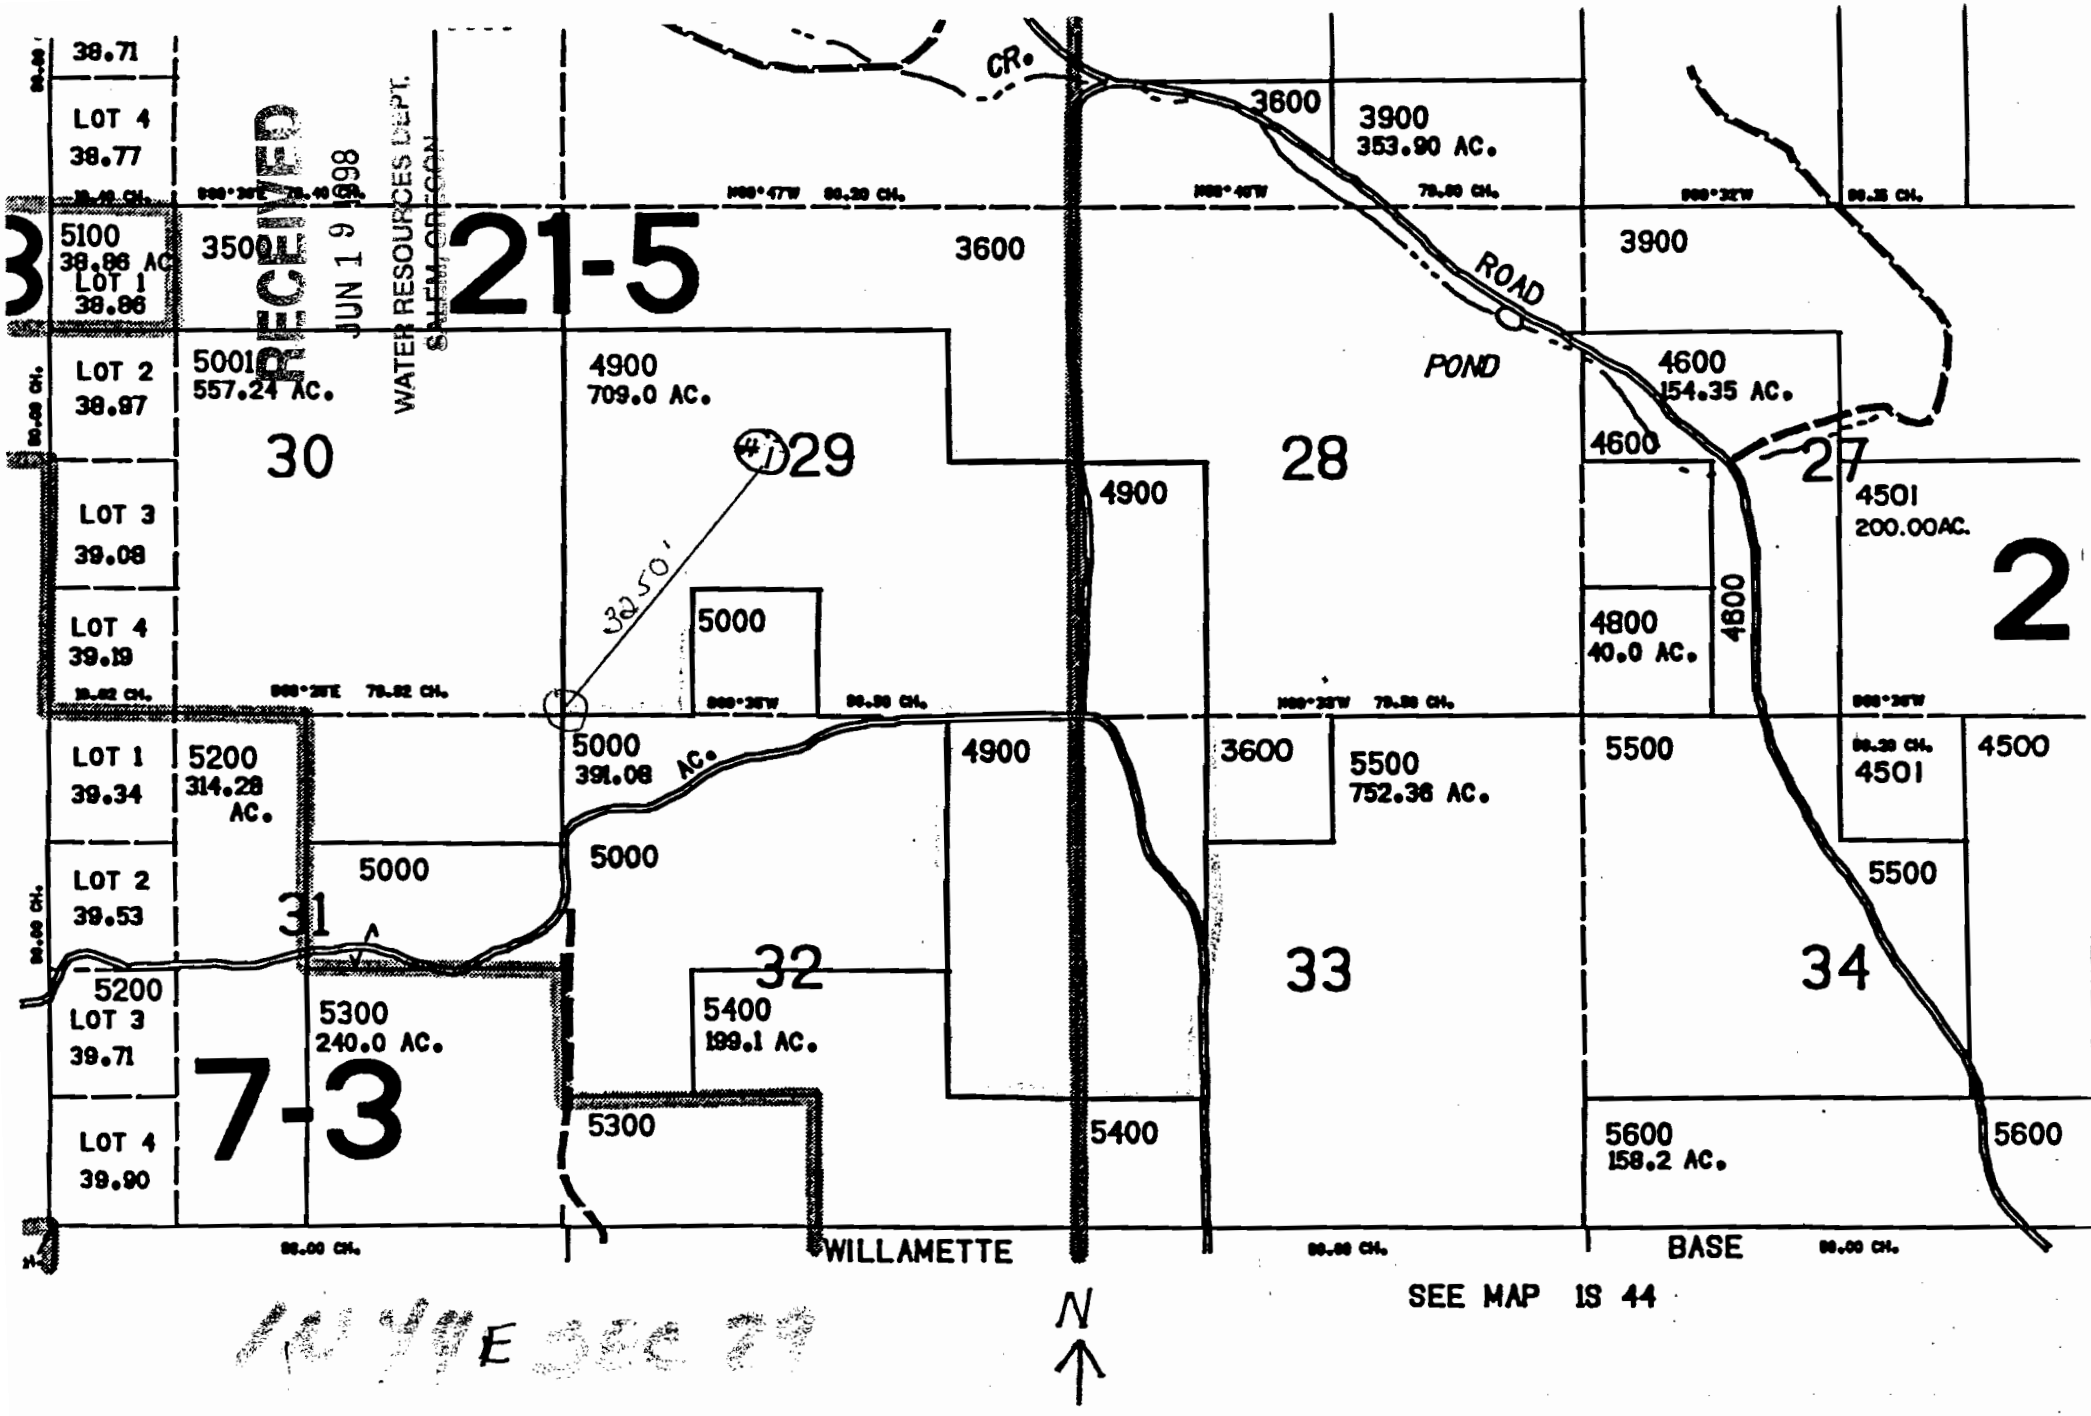


NE 1/4 SW 1/4