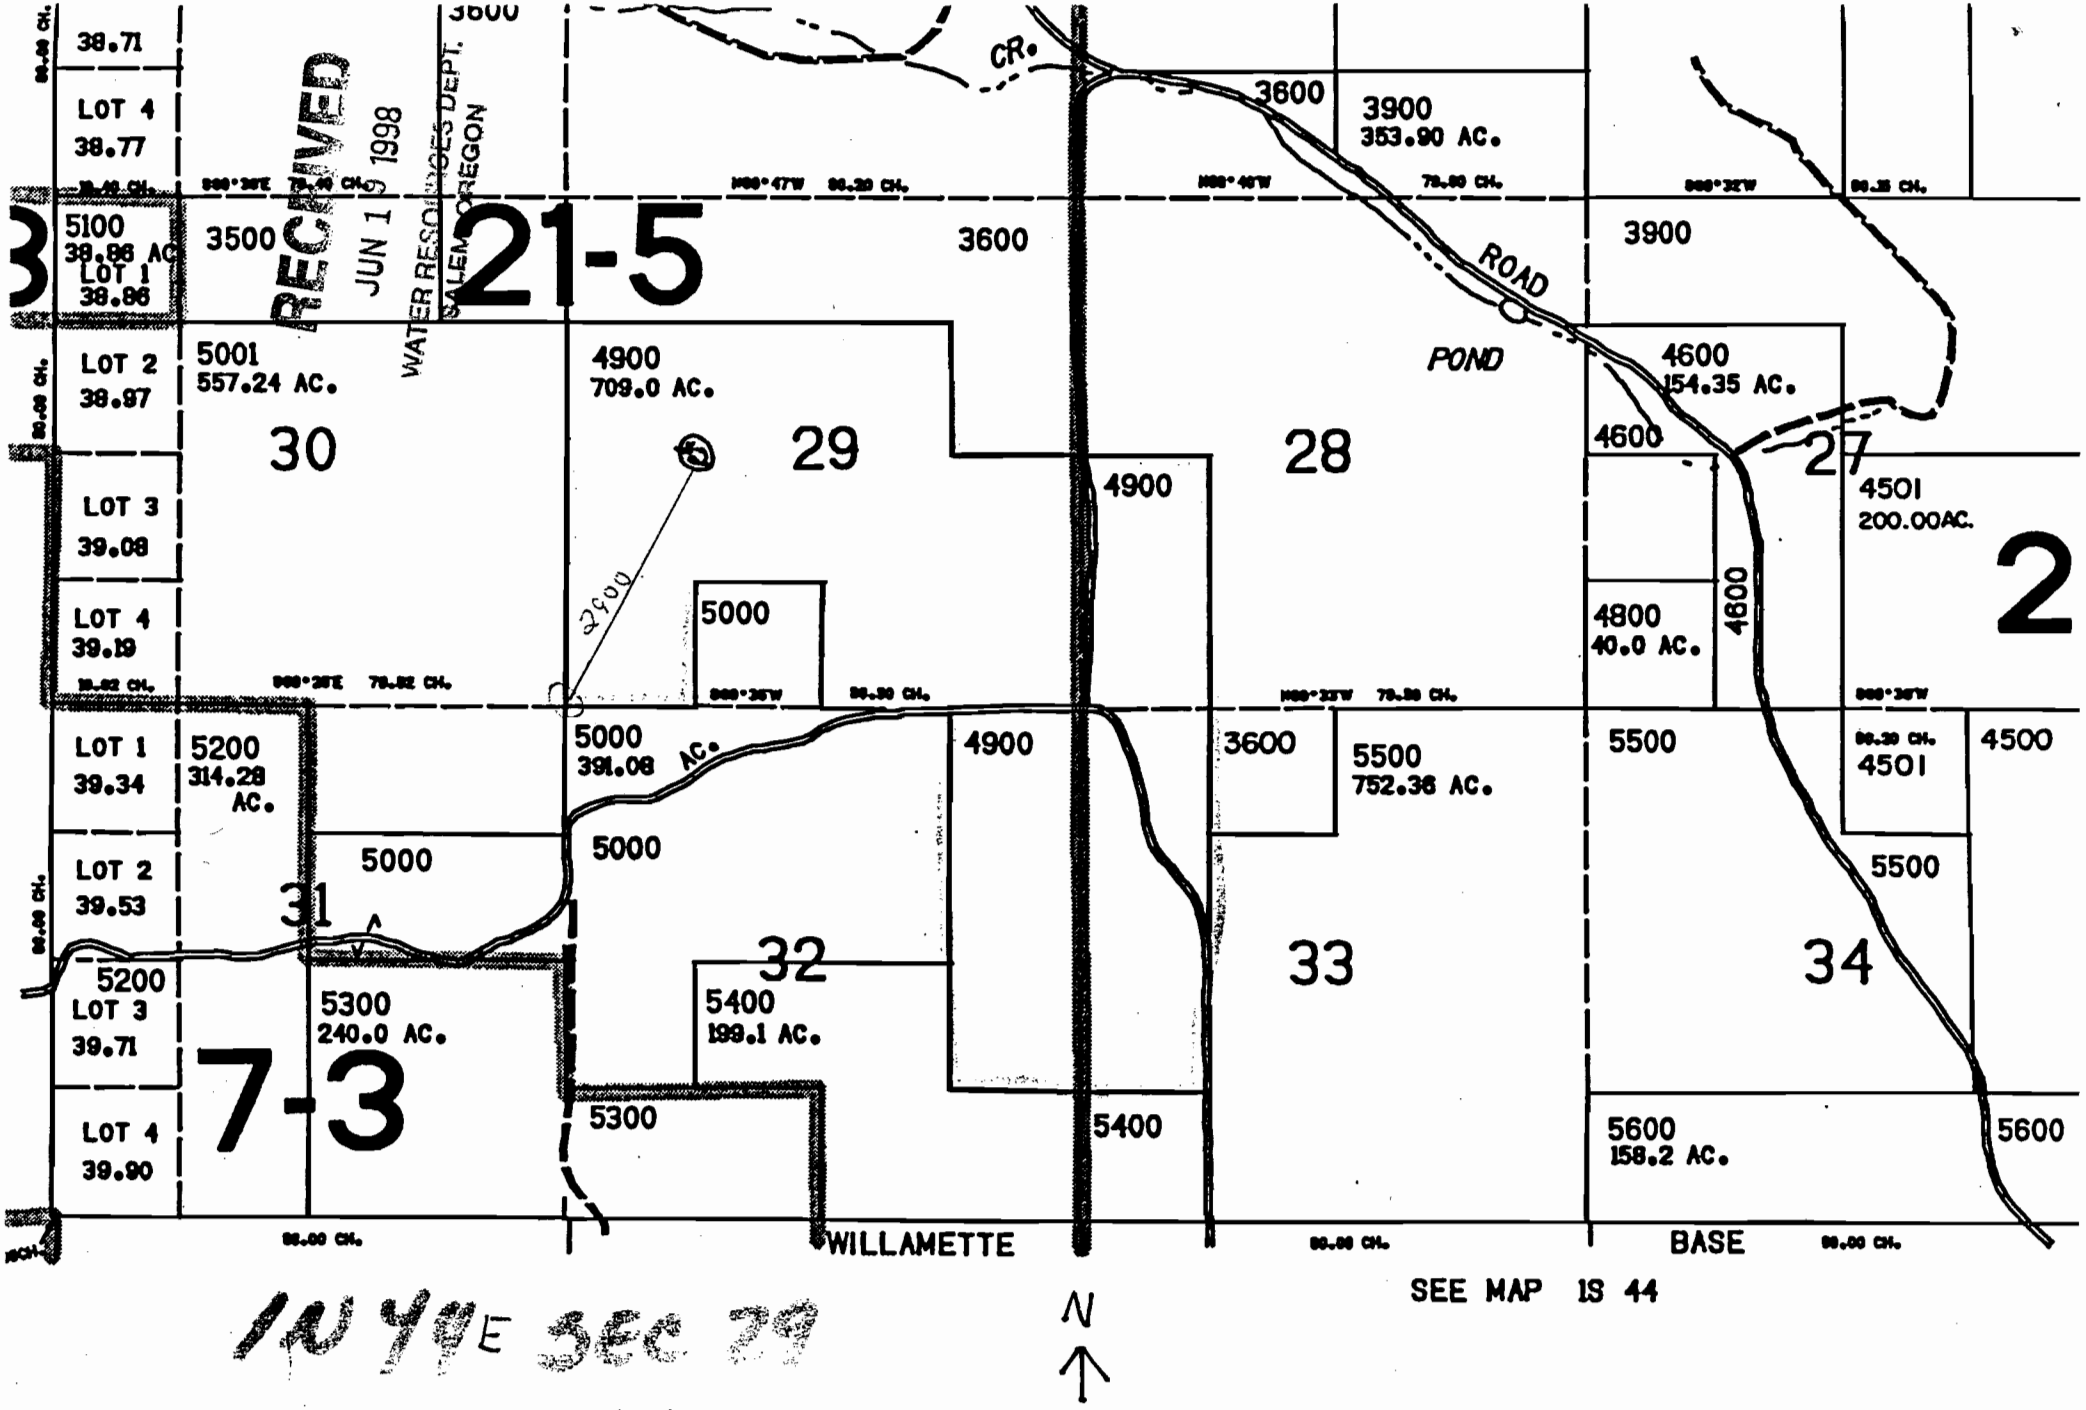


NW¼ SW¼,