


T. 2S. R. 1E. W.M.

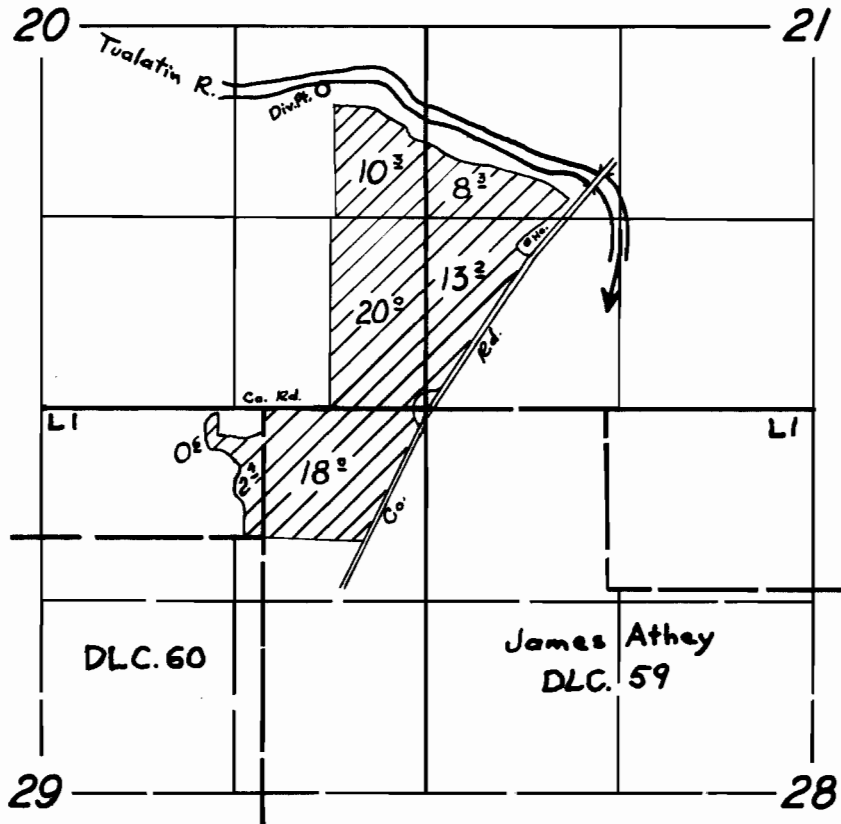

**FINAL PROOF SURVEY**  
UNDER

Application No. 29651 Permit No. 23350  
IN NAME OF

L. H. WANKER

Surveyed 27 June 1956, by M. Bish

DFK-5D-88  
DFK-3D-09

RAW