


T. 5S. R. 1E. W.M.

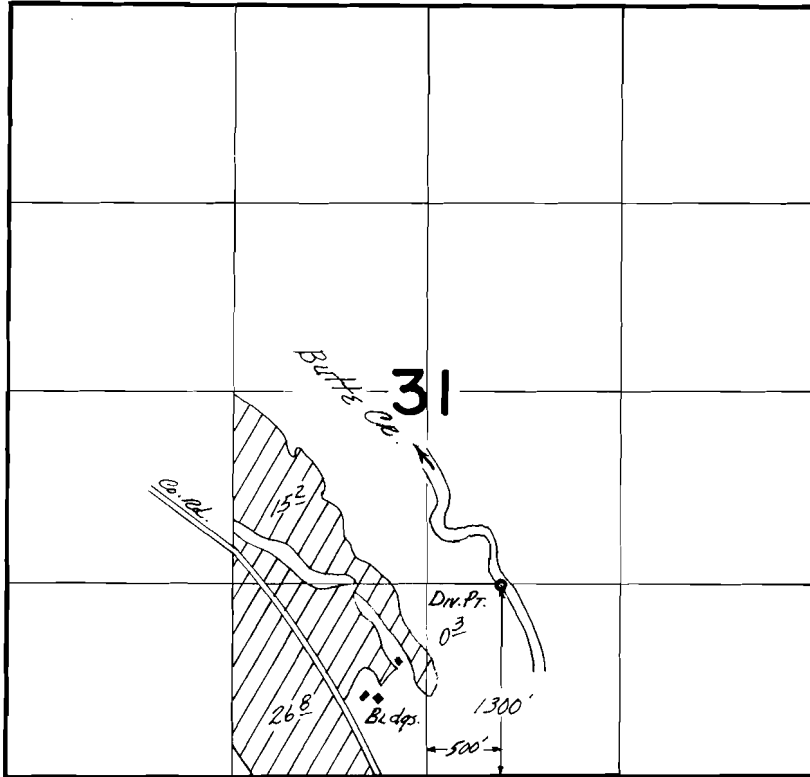

FINAL PROOF SURVEY UNDER

Application No. 53407... Permit No. 39747...
IN NAME OF

.....*Dickman Farms, Inc.*.....

Surveyed Sept. 5... 1979., by C.R. RODRIGUEZ