



FINAL PROOF SURVEY MAP

IN THE NAME OF HAROLD AND/OR SALLY RUSSELL

SECTION 34, T 27 S, R 14 W, W.M.
and
SECTIONS 3 & 4, T 28 S, R 14 W, W.M.

APPLICATION G-12359

PERMIT G-11375

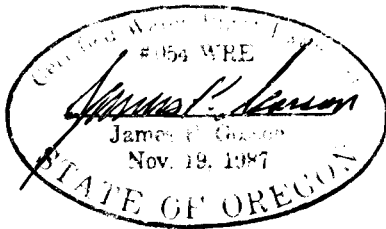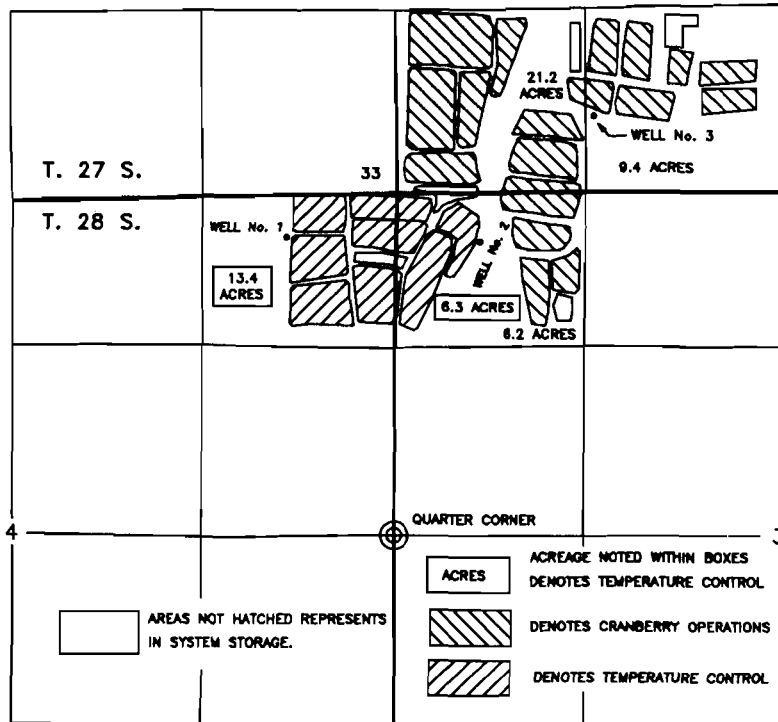

THE POINTS OF DIVERSION ARE LOCATED AS FOLLOWS:

| WELL No. | NORTH | EAST/WEST | ¼ ¼ SECTION | SECTION | TOWNSHIP/RANGE |
|----------|-----------|----------------|-------------|---------|----------------------|
| No. 1 | 2060 FEET | 740 FEET WEST | NE¼ NE¼ | 4 | T 28 S, R 14 W, W.M. |
| No. 2 | 2040 FEET | 590 FEET EAST | NW¼ NW¼ | 3 | T 28 S, R 14 W, W.M. |
| No. 3 | 2900 FEET | 1370 FEET EAST | SE¼ SW¼ | 34 | T 27 S, R 14 W, W.M. |

ALL FROM THE EAST QUARTER CORNER OF SECTION 4, TOWNSHIP 28 SOUTH, RANGE 14 WEST, W.M.;
COOS COUNTY.

THE PURPOSE OF THIS MAP IS TO IDENTIFY THE LOCATION OF THE WATER RIGHT.
IT IS NOT INTENDED TO PROVIDE INFORMATION RELATIVE TO THE LOCATION OF
PROPERTY OWNERSHIP BOUNDARY LINES.