


# T. 34 S., R. 8 W., W. M.

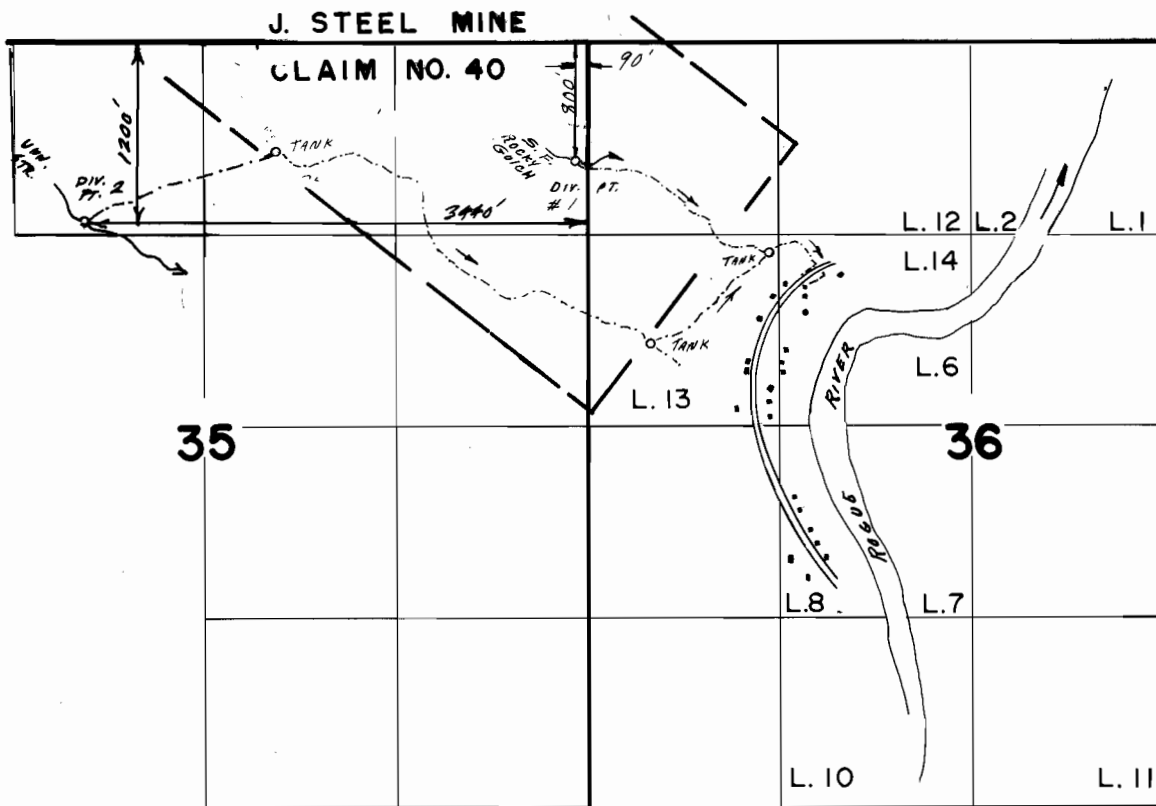

Scale: 1" = 1320'

## FINAL PROOF SURVEY UNDER

Application No. 68586 Permit No. 49874

IN NAME OF

GALICE SUB. WATER CO.

Surveyed OCT. 28. 1987. by B. S. JAMES.