


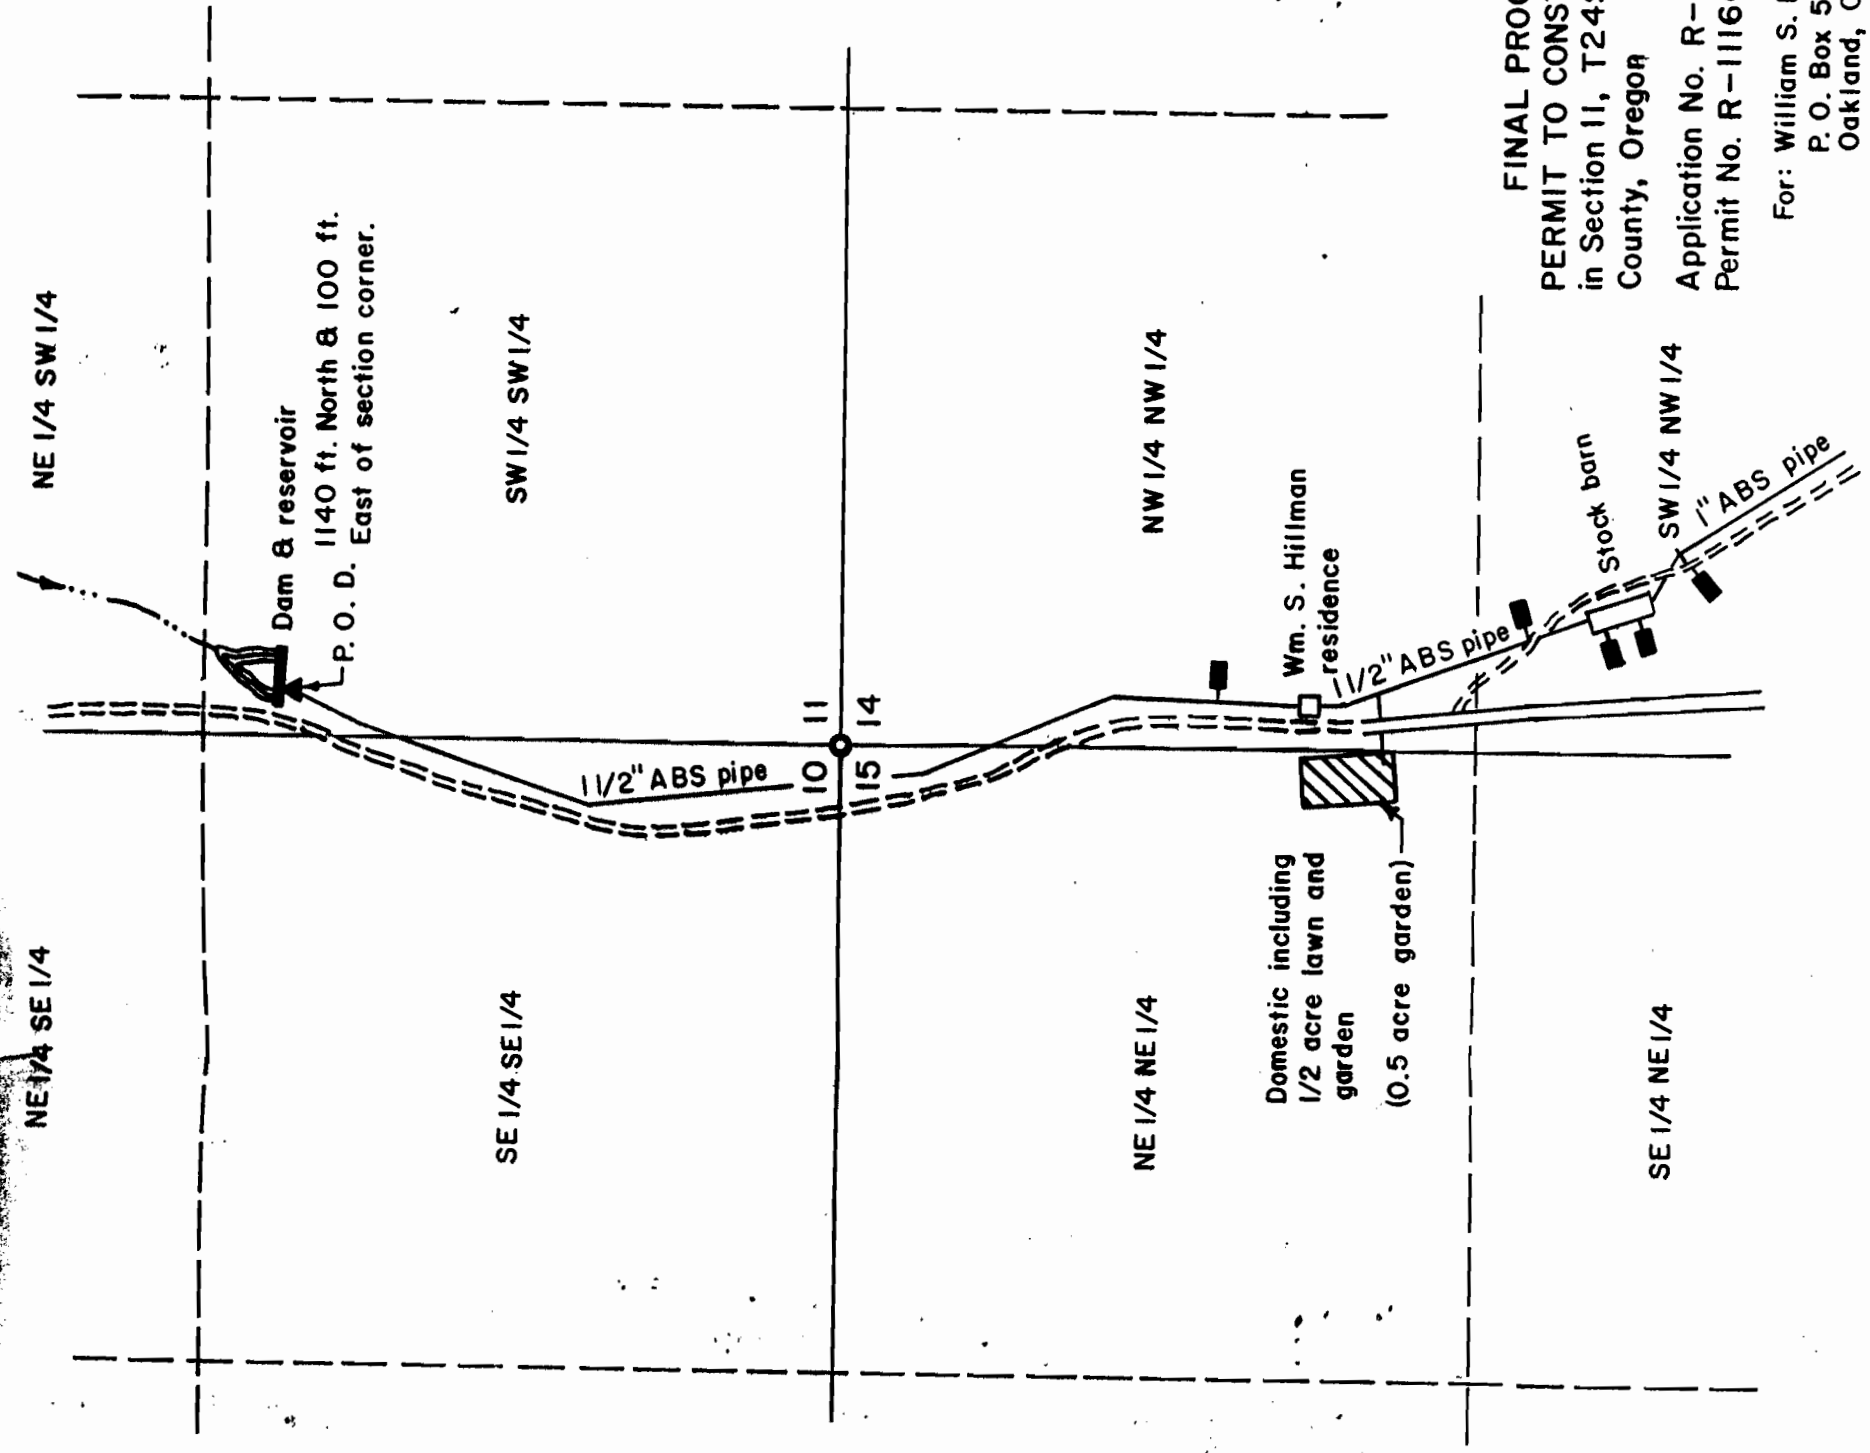

Scale: 1" = 400'

LEGEND

- Point of diversion
- Stock water trough
- Irrigated area
- Water distribution main
- 1" ABS pipe



Certified Water Right Examiner
#118 WRE
B.A. Shaner
Bruce A. Shaner
Nov. 19, 1987
STATE OF OREGON

Note:
See Application No. 69734,
Permit No. 50765.

FINAL PROOF SURVEY OF A
PERMIT TO CONSTRUCT A RESERVOIR
in Section 11, T24S, R6W, W.M., Douglas
County, Oregon
Application No. R-69733
Permit No. R-11166

For: William S. Hillman
P. O. Box 52
Oakland, Oregon 97462
By: Shaner Engineering, Inc.
P. O. Box 1430
Roseburg, Oregon 97470

RECEIVED
SEP 30 1993
WATER RESOURCES DEPT.
SALEM, OREGON

September 27, 1993