




Scale: 1" = 400'


LEGEND

- Point of diversion
- Stock water trough
- Irrigated area
- Water distribution main

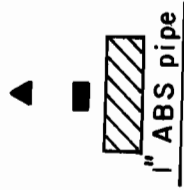

Note:
See Application No. 69734,
Permit No. 50765.

RECEIVED

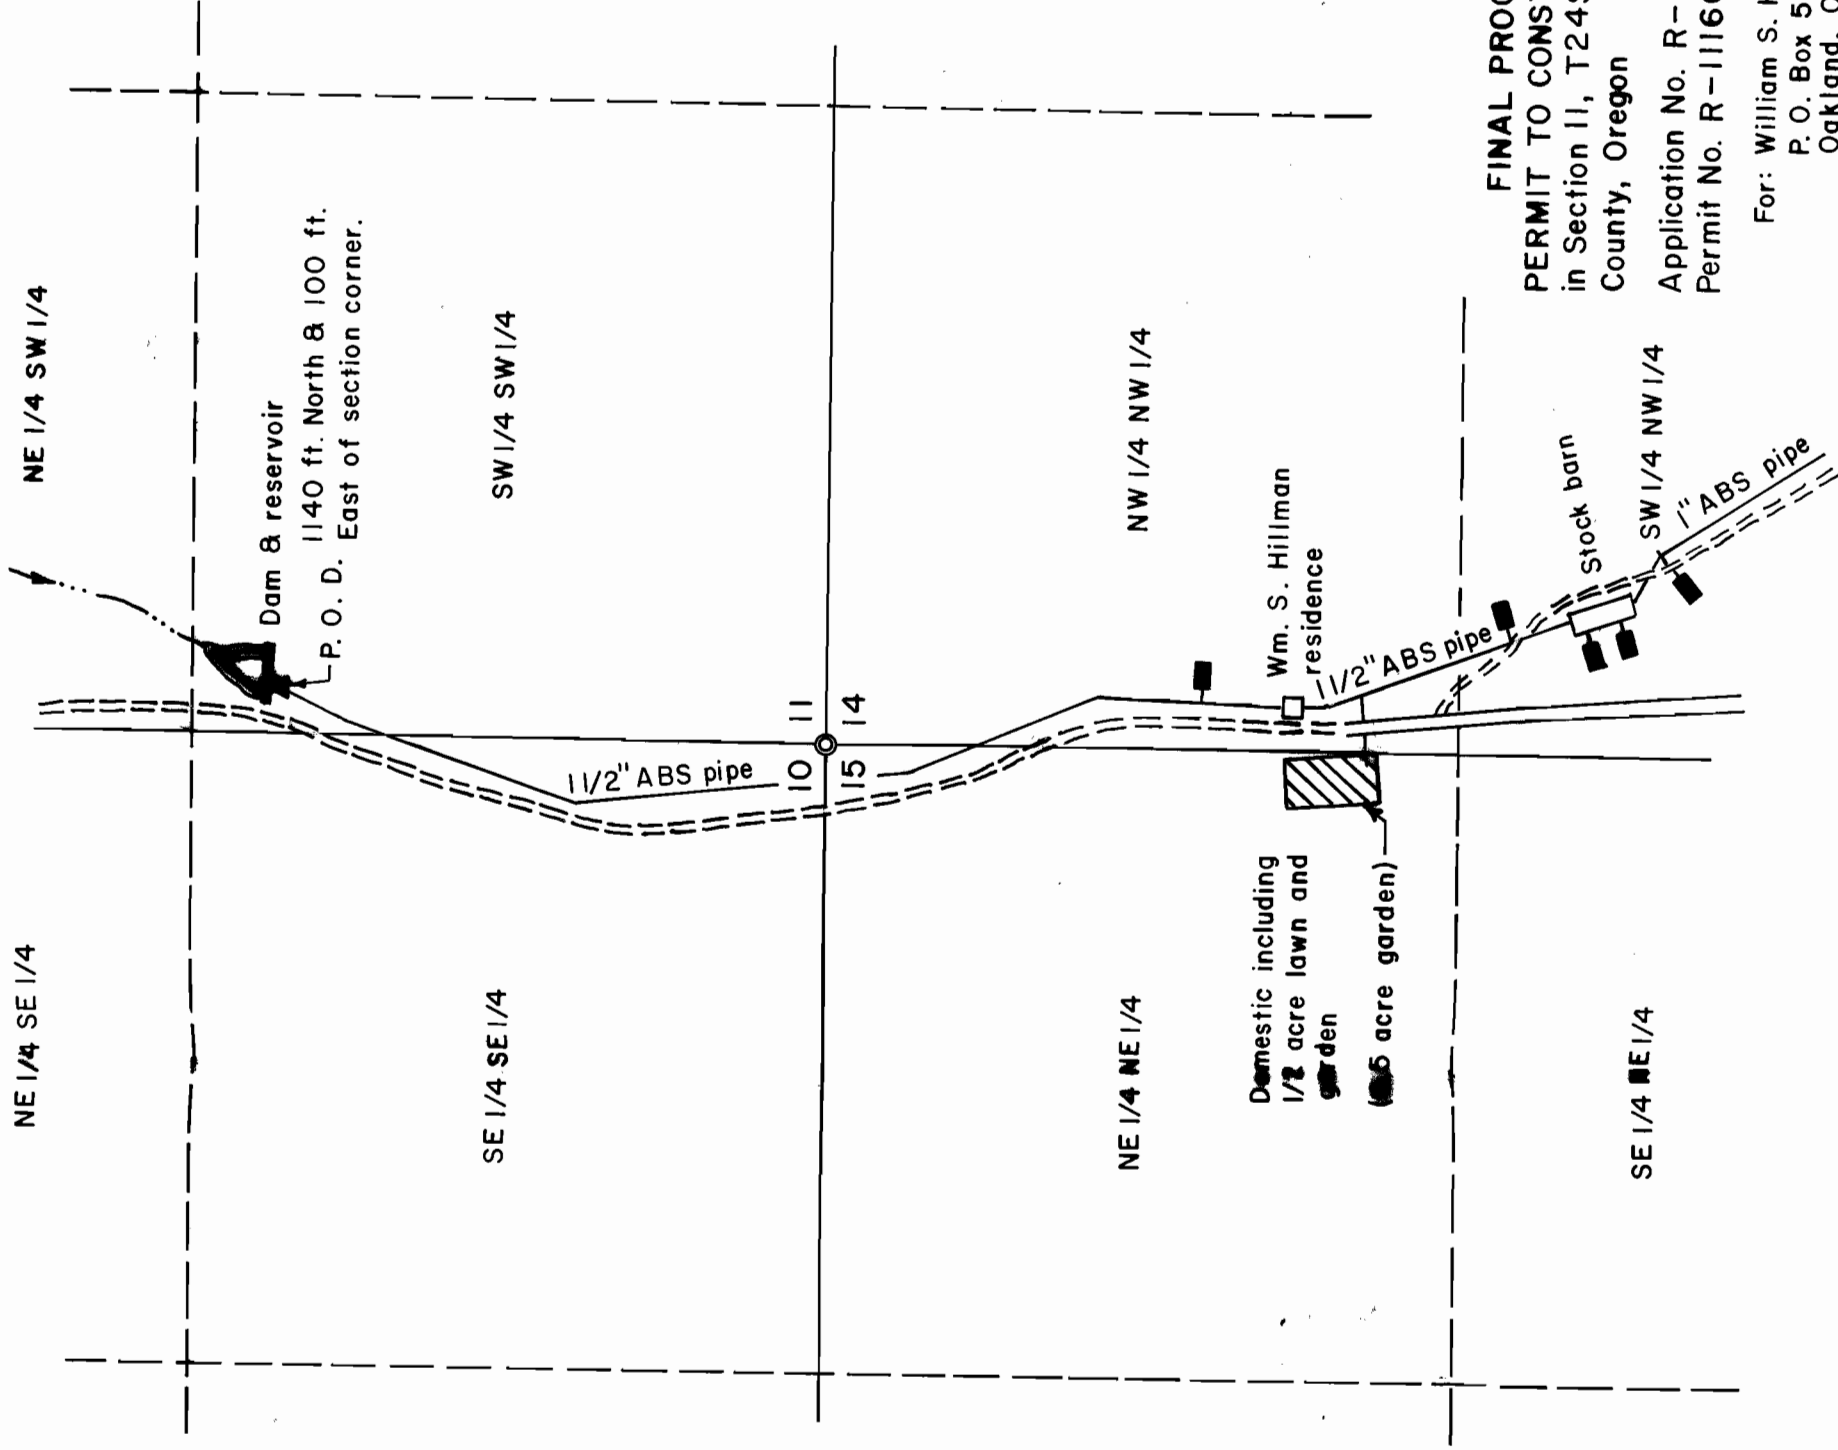

FINAL PROOF SURVEY OF A
PERMIT TO CONSTRUCT A RESERVOIR
in Section 11, T24S, R6W, W.M., Douglas
County, Oregon
Application No. R-69733
Permit No. R-11166

For: William S. Hillman
P.O. Box 52
Oakland, Oregon 97462
By: Shaner Engineering, Inc.
P.O. Box 1430
Roseburg, Oregon 97470

September 27, 1993

