

Section 20 Township 23S Range 12W W.M.

Coos County

RECEIVED


NOV 21 1996

WATER RESOURCES DEPT.
SALEM, OREGON

RECEIVED


MAR - 7 1997

WATER RESOURCES DEPT.
SALEM, OREGON

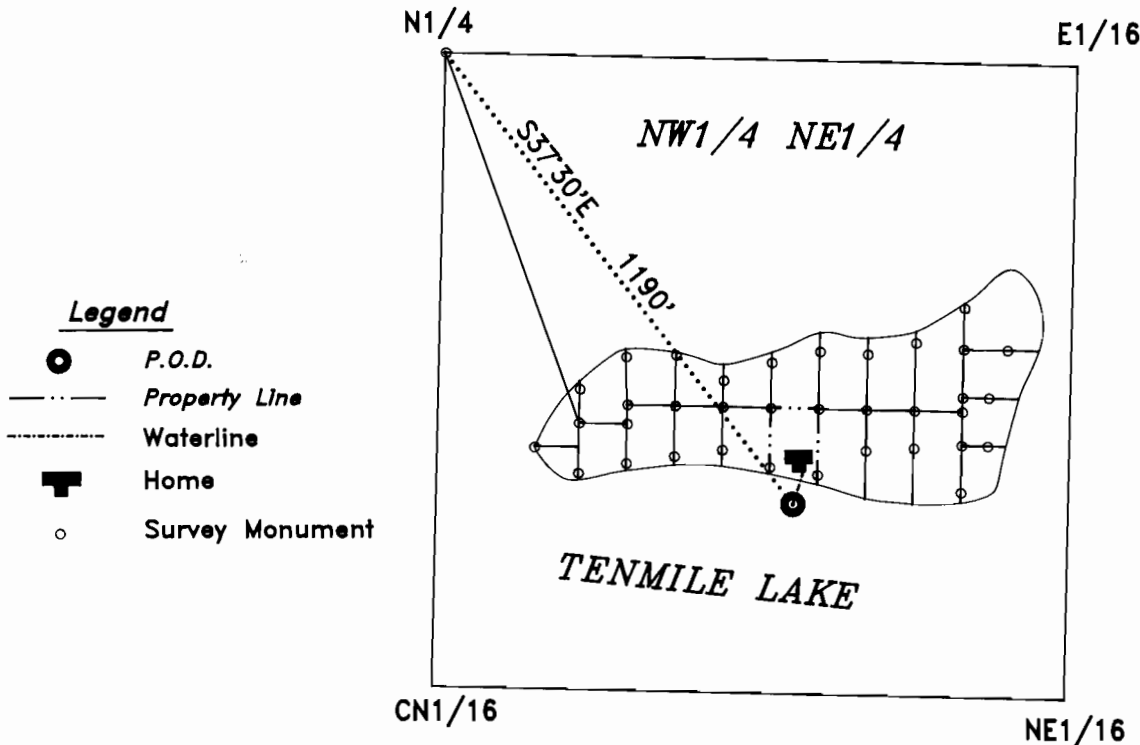

EXAMINERS DISCLAIMER STATEMENT

The preparation of this map was for the purpose of identifying the location of the Water Right only and has no intent to provide dimensions or location of property ownership lines.

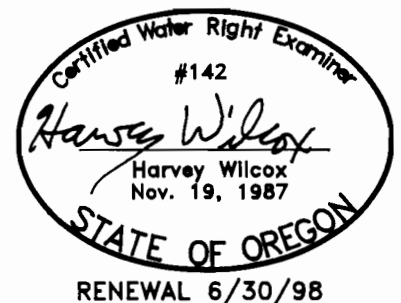

FINAL PROOF SURVEY
IN THE NAME OF
Lloyd and Linda Webb

Surveyed on 10/26/96 by H.A. Wilcox

Application No. S-81045
Permit No. 53089