


T. 6 S. R. 5 W. W. M.

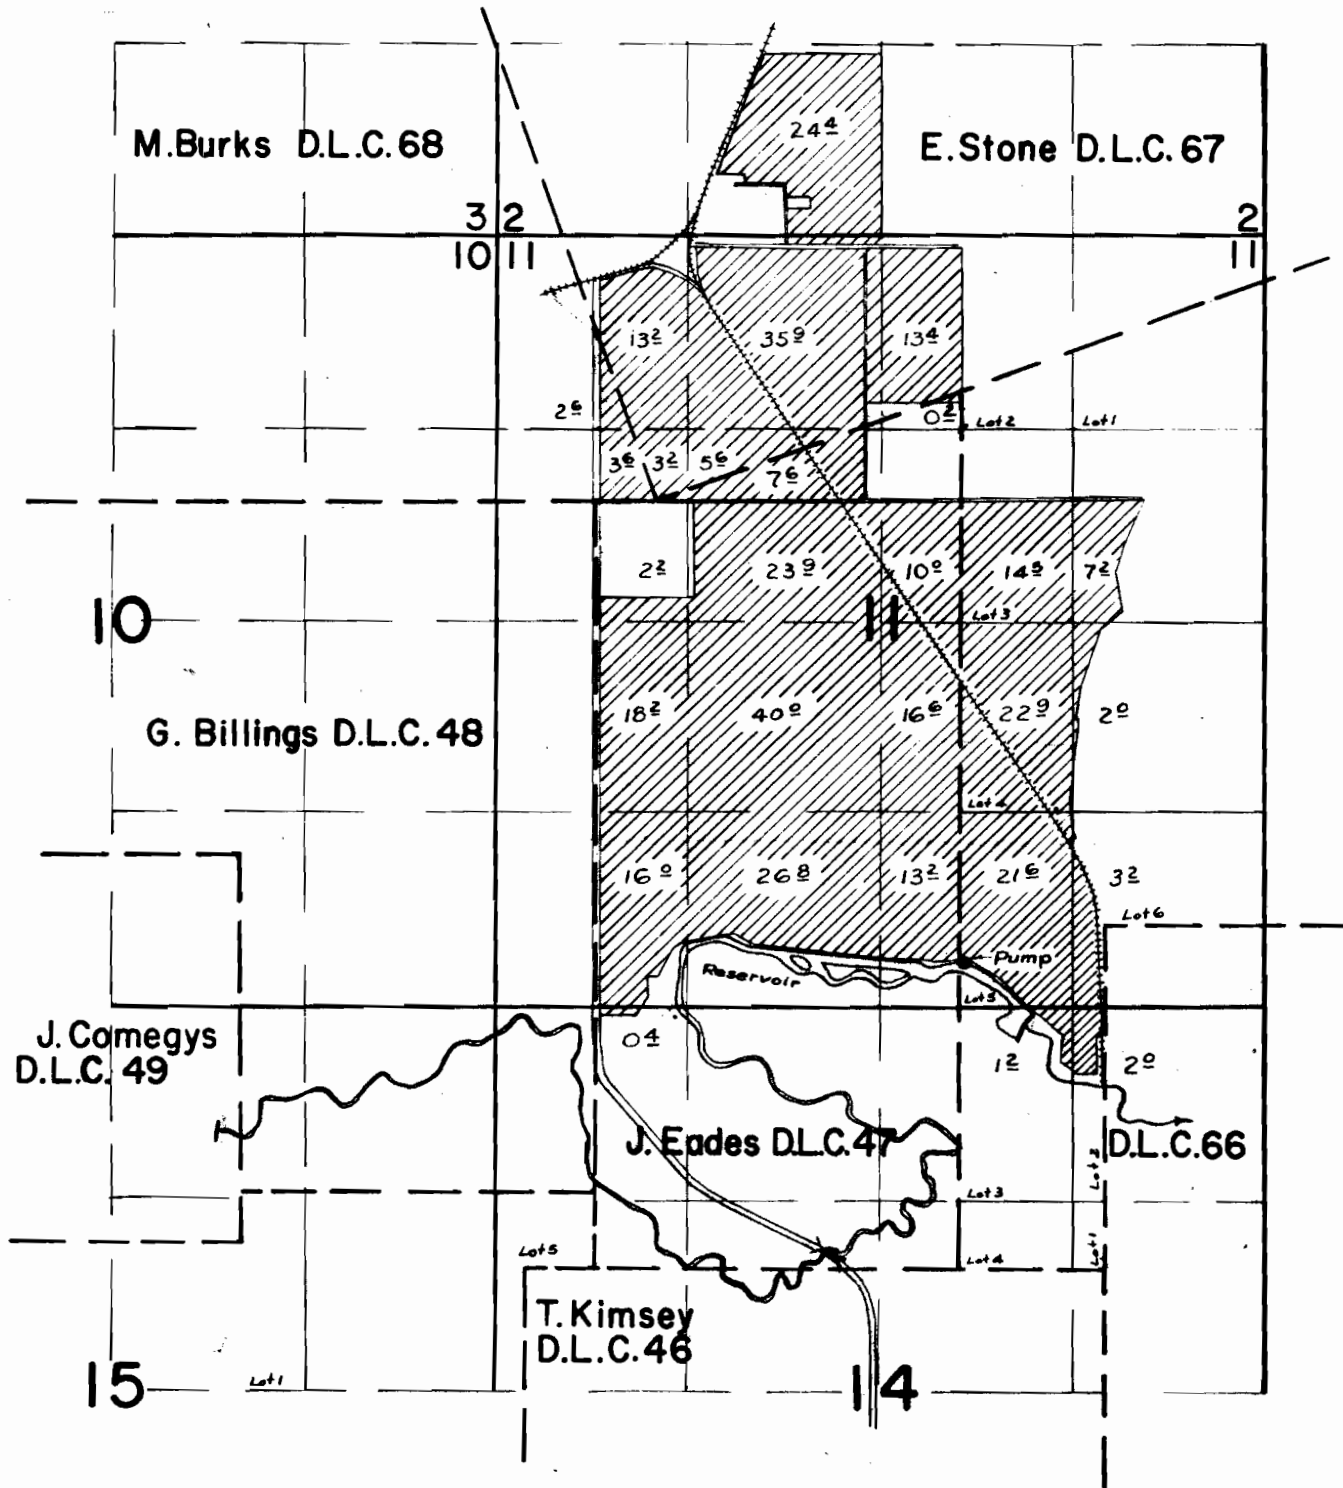

FINAL PROOF SURVEY

UNDER

Section No. 24552 21652
R-24551 R-1405

IN NAME OF

R. L. WALKER

July 28 61
Surveyed Sept. 9 1960, by W. B. Rich