

T.35 S., R.2 W., W.M.


RECEIVED

31

32

NW 1/4, SW 1/4

NE 1/4, SW 1/4

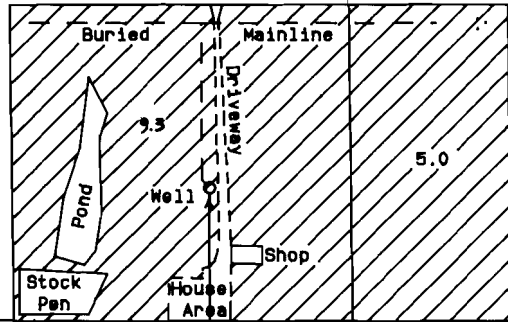

No. 41' 20" W Basis of Bearing Survey No. 3955.

SW 1/4, SW 1/4

SE 1/4, SW 1/4

North

East 1012

31


32

32

6

5

The preparation of this map was for the purpose of identifying the water right only & has no intent to provide dimension or location of property ownership lines.

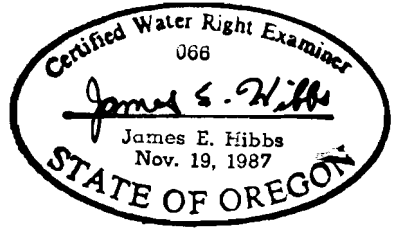

FINAL PROOF MAP

under

Application No. 6-11973 Permit No. 611044.
in name of

BURLYN A. STEVENS

Mapped April 2, 1993 Scale: 1" = 400'

Mapped by: L.J. Friar & Associates P.C.
Consulting Land Surveyors
304 South Holly Street
Medford, OR 97501
(503) 772-2782

5