

CLAIM OF BENEFICIAL USE
FINAL PROOF MAP

Located in the NE1/4 NW1/4 of Section 9
Township 23 South, Range 12 West, W.M.
Coos County, Oregon
Application S-80952 Permit 53051

RECEIVED

OCT 06 1998


WATER RESOURCES DEPT
SALEM, OREGON

Scale 1" = 100 Feet
Assessors Scale

Prepared For: Donald R. & Shirley J. Patterson
Prepared By: Dennis Goude
Date Prepared: June 26, 1998

NOTE:

The P.O.D. is a 1/2 HP submersible pump located 1225 feet South and 125 feet West of the N1/4 corner of Section 9.

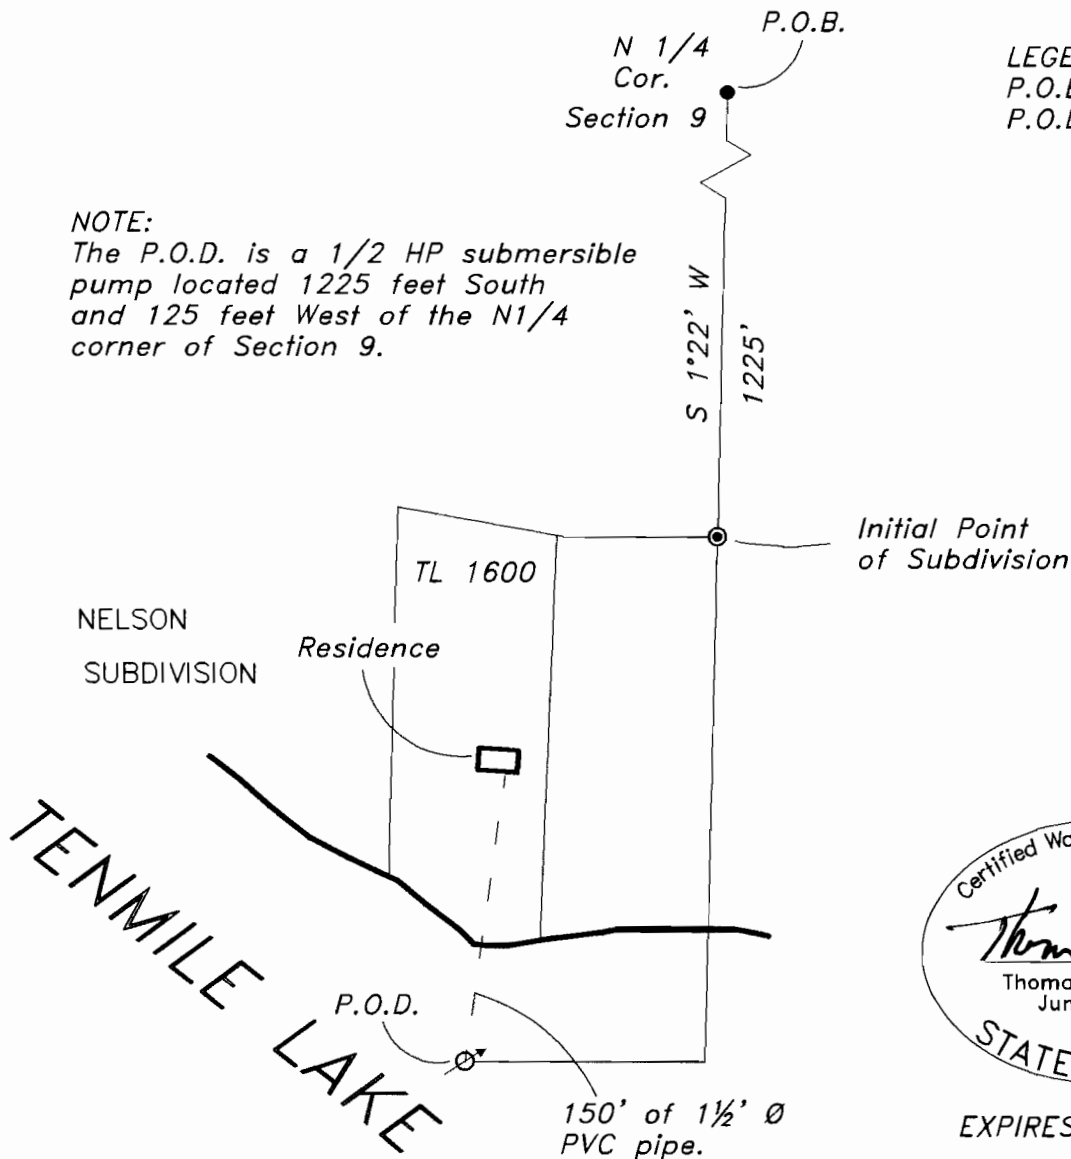

EXPIRES 06/30/99

EXAMINERS DISCLAIMER STATEMENT

The preparation of this map was for the purpose of identifying the location of the Water Right only and has no intent to provide dimensions or location of property ownership lines.

Stuntzner Engineering
& Forestry, L.L.C.

ENGINEERING • LAND SURVEYING • FORESTRY
PLANNING • WATER RIGHTS

705 South 4th St.
Post Office Box 118
Coos Bay, Oregon 97420

Phone: (541) 267-2872
Fax: (541) 267-0588