


T.33S. R.2E.W.M.

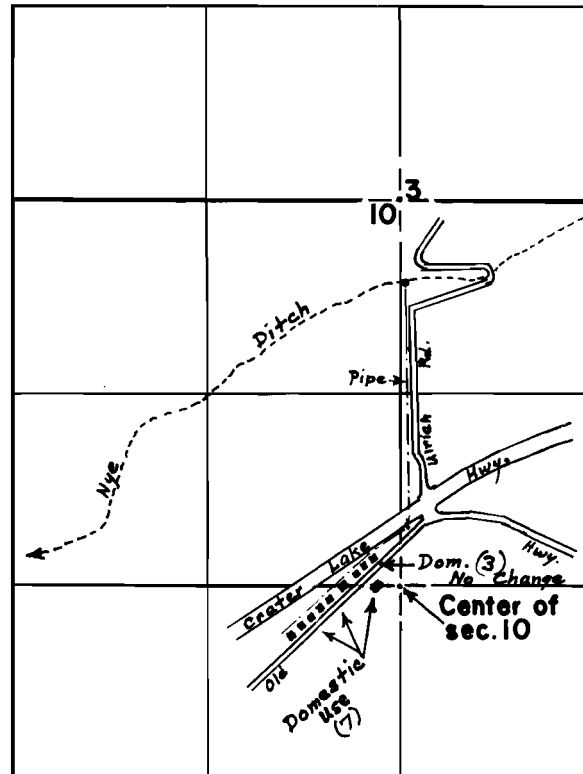

FINAL PROOF SURVEY
UNDER

Trans. No. 0-36
Application No. _____ Permit No. _____
IN NAME OF

Olson-Lawyer Lumber Co.

Surveyed April 16, 1971, by D.C. Hendrix