


T.16S.R.43E.W.M.

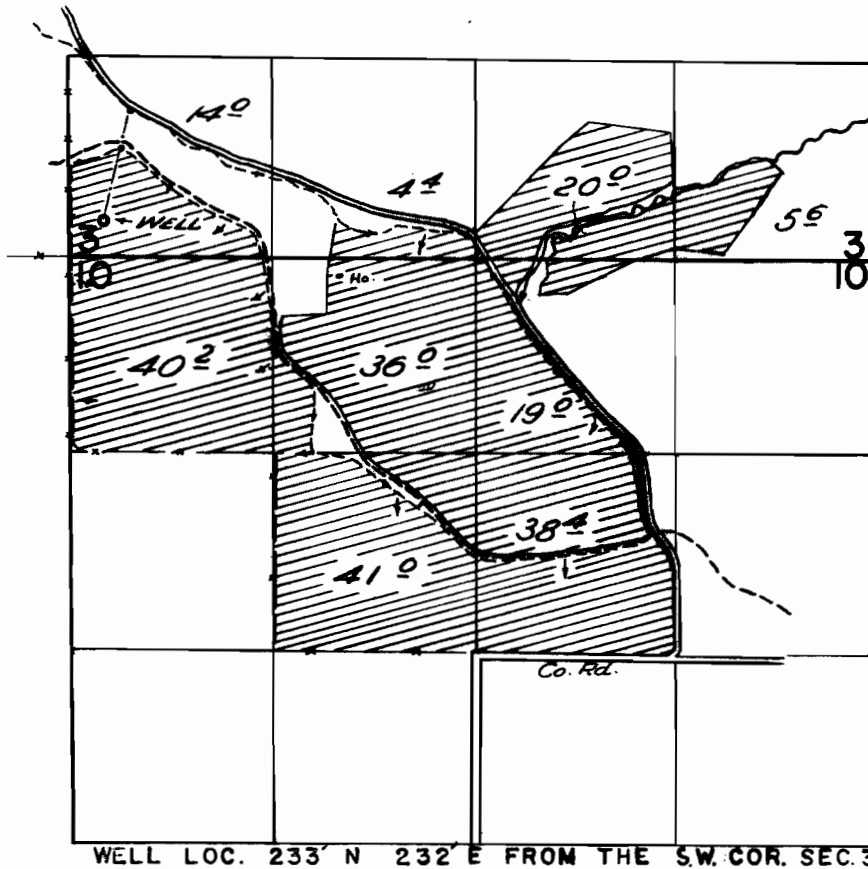

FINAL PROOF SURVEY UNDER

Application No. G-1452 Permit No. G-1366
IN NAME OF

STEVEN L. & MARY L. MCBRIDE

Surveyed 29 Oct. 1960, by Mr. Bick
20 Oct. 1961, by Mr. Johnson

1959 Q
BBC-7N-86
1961-K