


T.18S.R.43E.W.M.

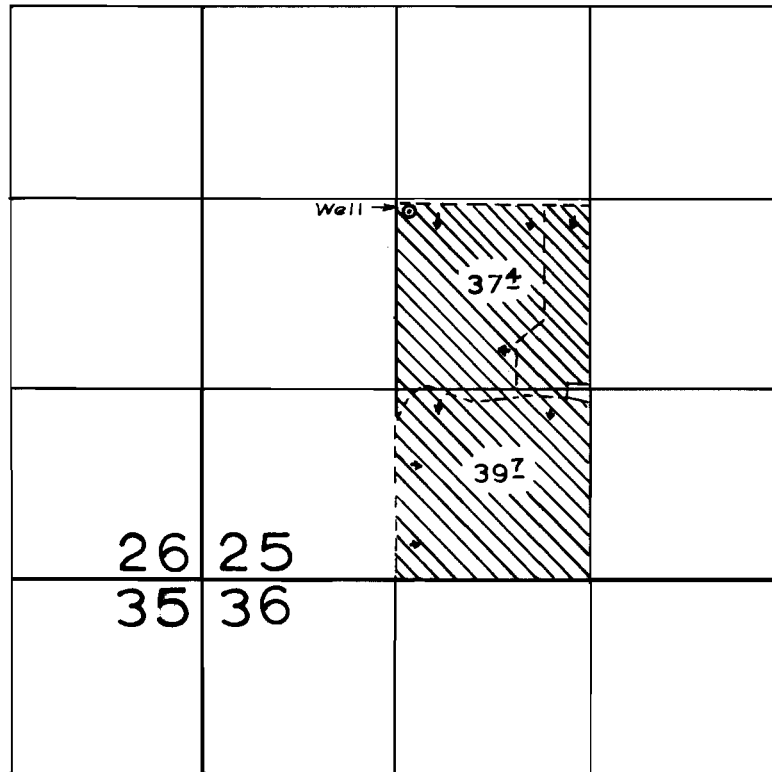

FINAL PROOF SURVEY
UNDER

Application No. G-2294 Permit No. G-2116.....
IN NAME OF

MAURICE W. FORD.....

Surveyed APRIL 14... 1965., by *F.W. Elving*.....