


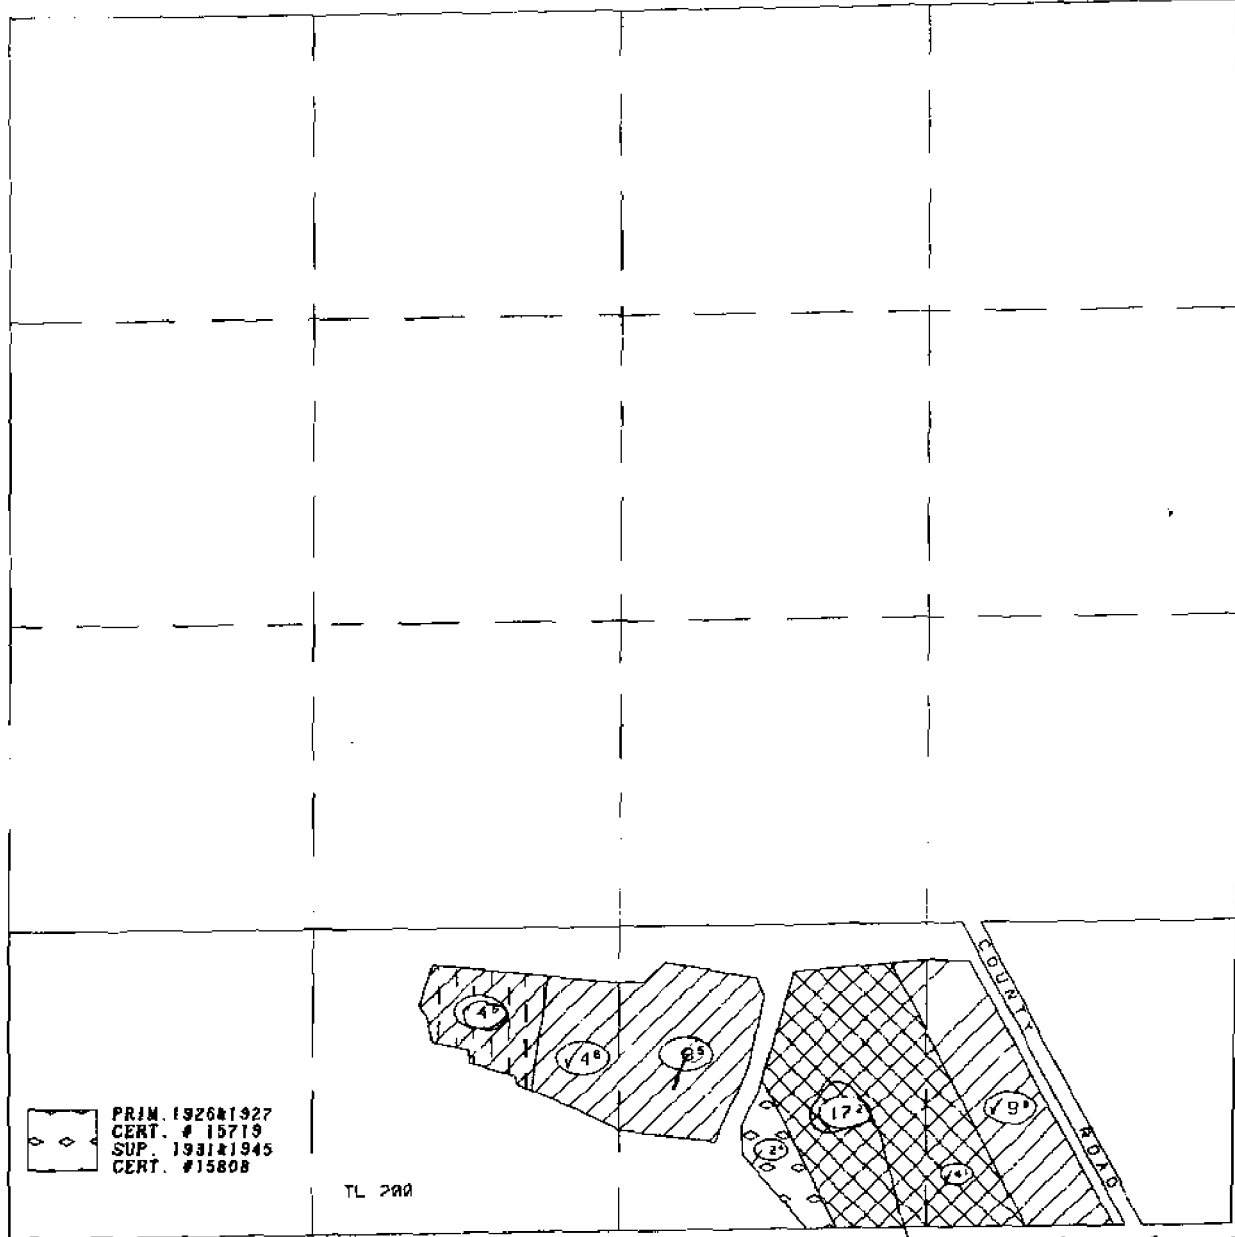







722

SECTION 23  
T19 S. R41 E. W.M.



Should this be 14.8 ac?

-  PRIMARY 1883  
CERT. # 7008  
SUP. 1926&1927  
CERT. #15719  
SUP. 1931&1945  
CERT. #15808
-  PRIMARY 1832  
CERT. # 6886  
SUP. 1926&1927  
CERT. #15719  
SUP. 1931&1945  
CERT. #15808
-  PRIMARY 1883  
CERT. # 7027  
SUP. 1926&1927  
CERT. #15719  
SUP. 1931&1945  
CERT. #15808
-  IRR ACRES
-  PROPERTY BOUNDARY
-  BURIED PIPE
-  BRIDGE
-  DIVERSION DAM





Vale Oregon  
Irrigation  
District


HB 3111 Petition			
Page		of	Pages
Digitized By	RJ & LHP	Approved	


SCALE 1 INCH = 400 FEET


SECTION 31  
T19 S., R42 E., W.M.

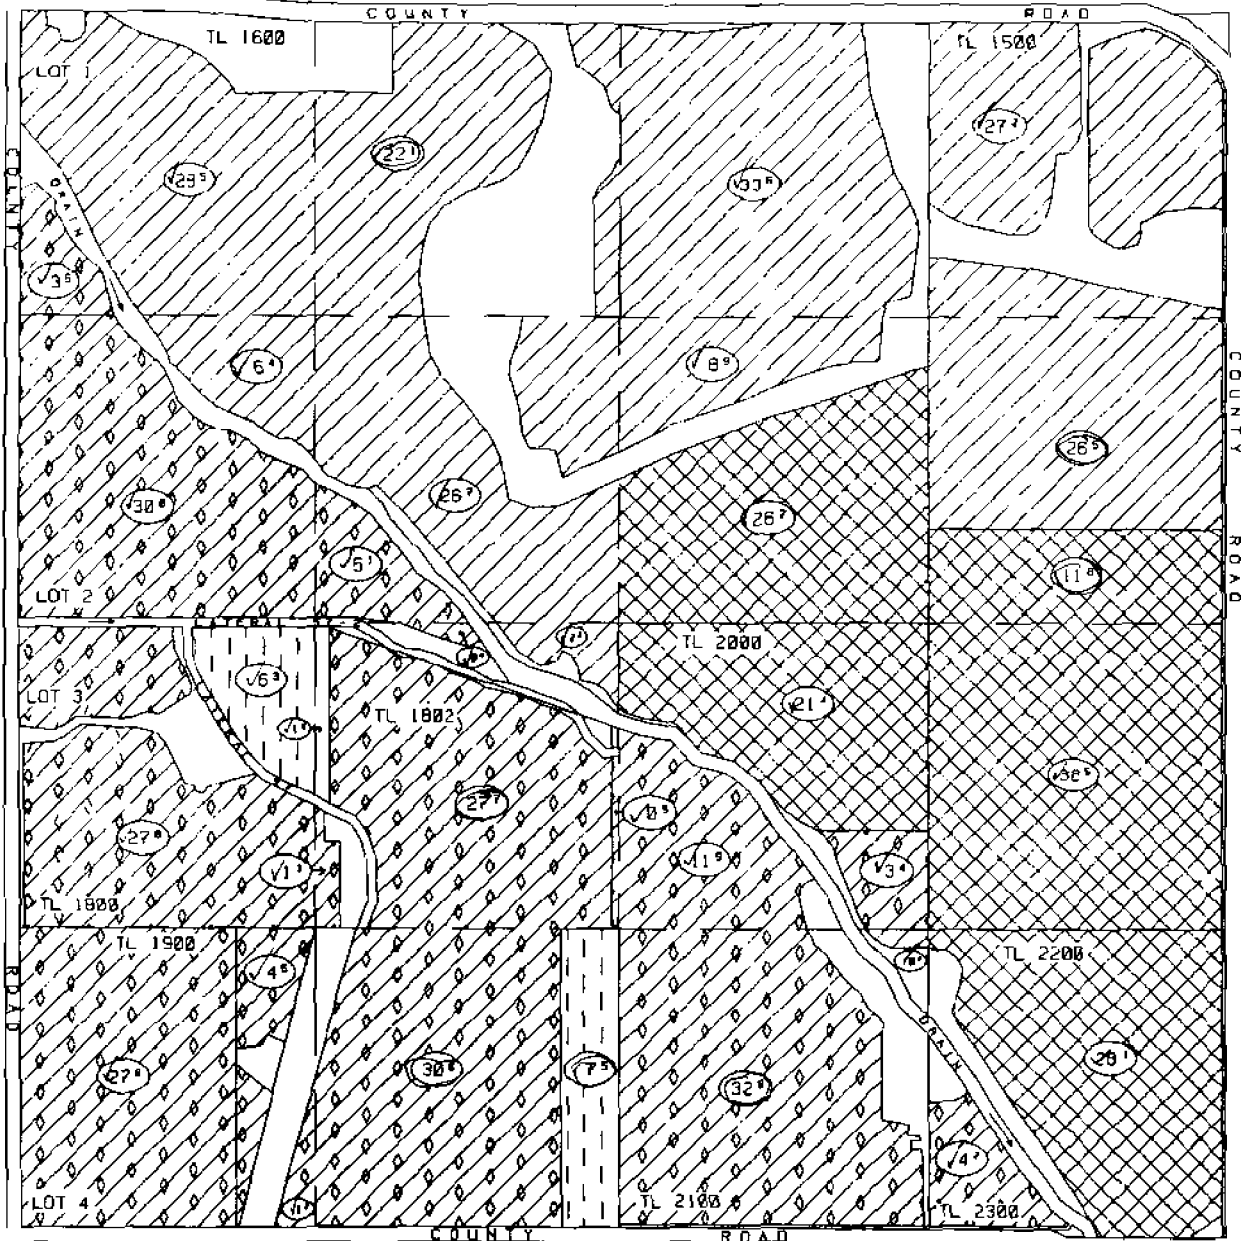


 PRIMARY 1885  
CERT. #51736  
SUP. 1926&1927  
CERT. #15719  
SUP. 1931&1945  
CERT. #15808


 PRIMARY 1892  
CERT. # 6866  
SUP. 1926&1927  
CERT. #15719  
SUP. 1931&1945  
CERT. #15808

 PRIMARY 1893  
CERT. #51737  
SUP. 1926&1945  
CERT. #15719  
SUP. 1931&1945  
CERT. #15808

 PRI. 1926&1927  
CERT. #15719  
SUP. 1931&1945  
CERT. #15808

 IRR. ACRES

  PROPERTY BOUNDARY

 BURIED PIPE

 BRIDGE

 DIVERSION DAM



Vale Oregon  
Irrigation  
District

HB 3111 Petition			
Page		of	Pages
Digitized By	RJ & LHP	Approved	

SCALE 1 INCH = 400 FEET