


T. 17 S., R. 44 E., WM

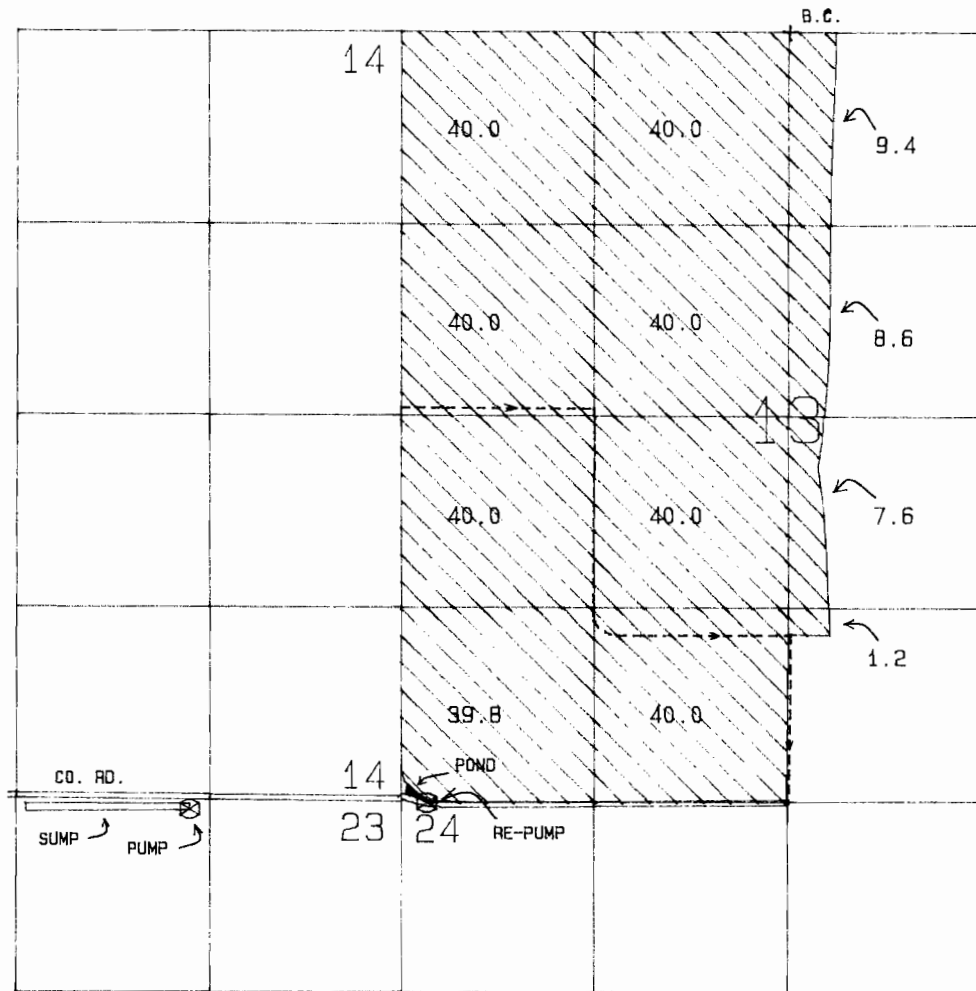

SUMP LOCATED: 60 FT SOUTH AND 1440 FT WEST FROM
THE NORTHEAST CORNER OF SECTION 23.

SCALE 1 IN = 1320 FT

FINAL PROOF SURVEY
UNDER

APPLICATION NO.: G-9459

PERMIT NO.: G-8702

IN THE NAME OF

O. T. FARMS, A PARTNERSHIP

SURVEYED MAY 27, 1986

BY: L. M. TOLL

COMPUTER DRAFTED: JCL
PHOTO 41045-478-66R
PTS-1986-V-A