


U-472

27978
68716
76224
76225

T.26 S.R.14 E.W.M.

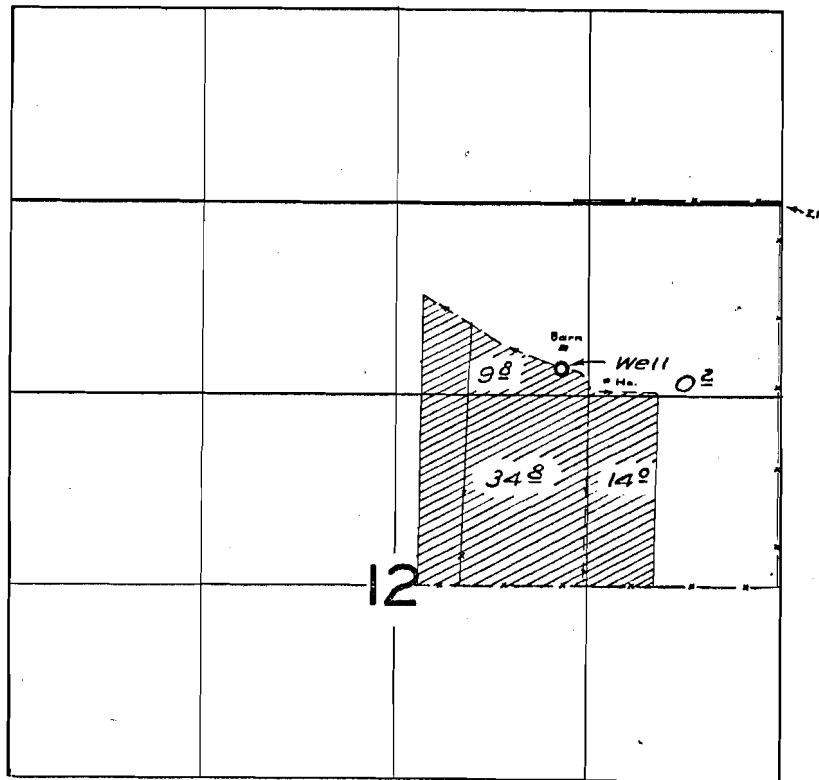

T-#3510

FINAL PROOF SURVEY UNDER

Application No. U-517.. Permit No. U-472..
IN NAME OF

Bud Baert

Surveyed 12 May 1959, by M. Bish

8-18-52