
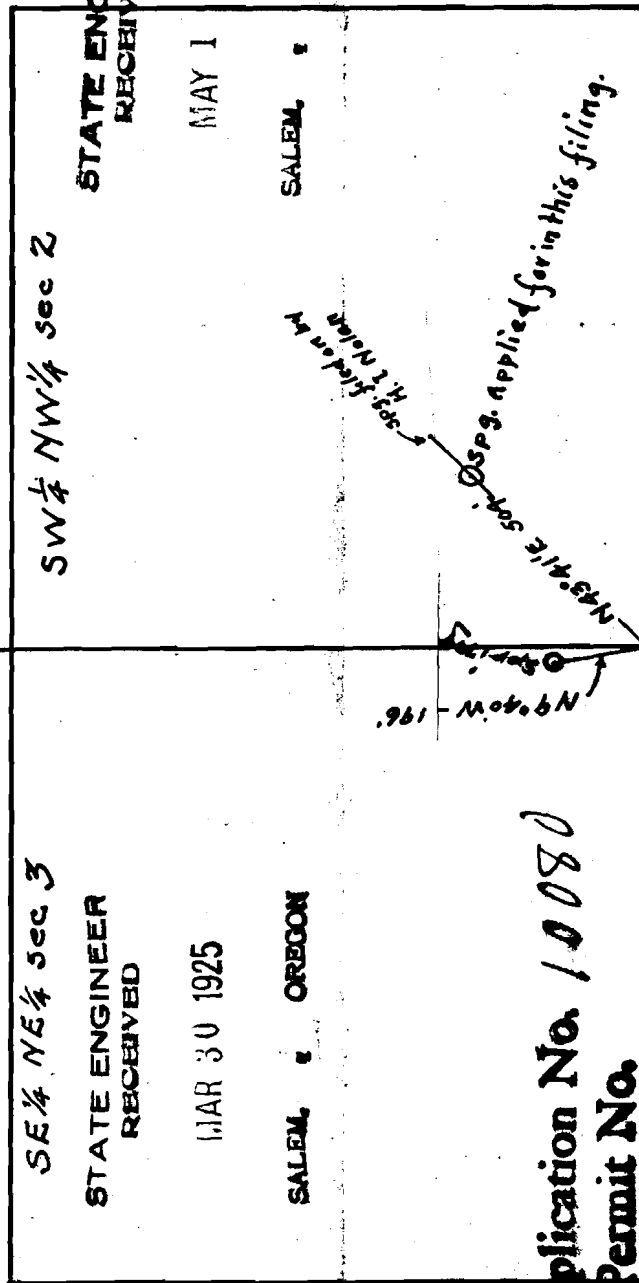


MAP of WATER FILING by ROBERT E. JORDAN
of GRANDVIEW OREGON
Tp 13S, Rg 11E of WM
Scale 1" = 400'

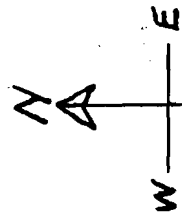

Application No. 10080
Permit No. 6749

I Raymond G Heider of Madras, Oregon do hereby certify that this map was made from notes taken during an actual survey made by me on March 26, 1925 and that it correctly represents the works described in the accompanying application together with the location of streams and other ditches in the immediate vicinity

Raymond G. Heider
county Surveyor

10080

6749

C-7623