


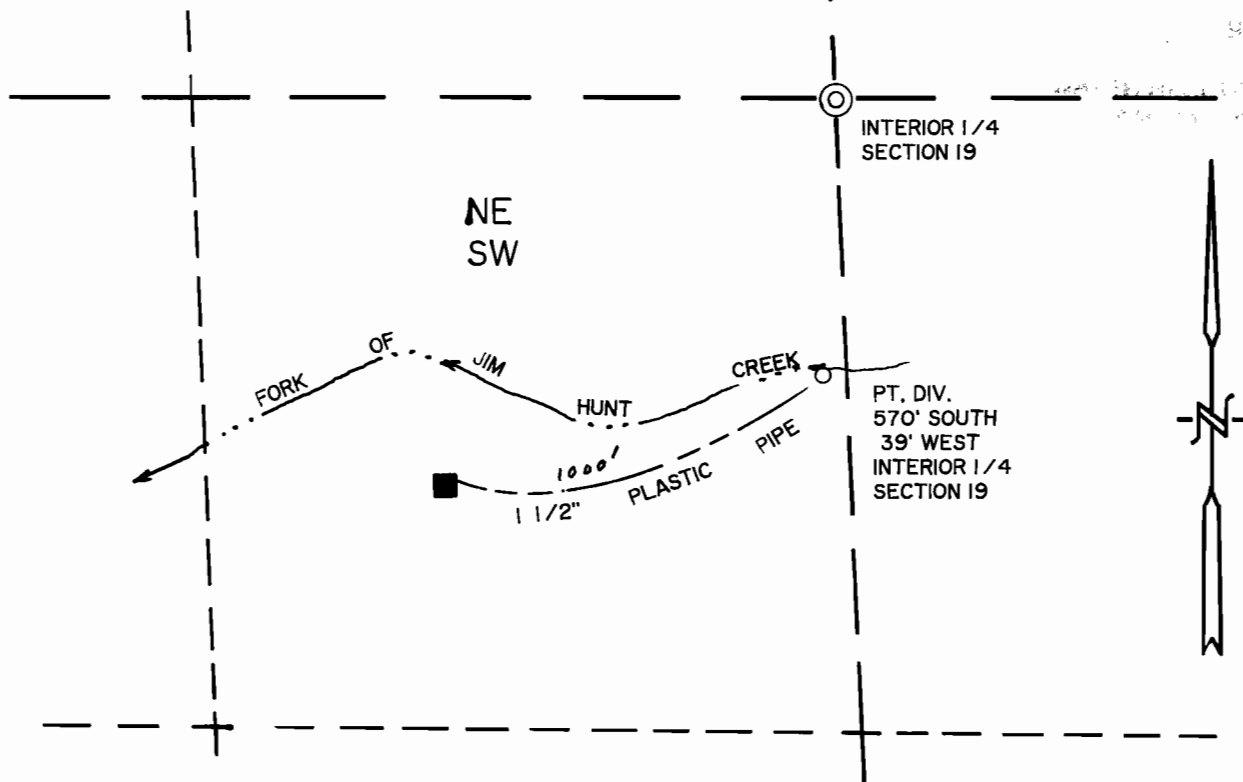

THE PREPARATION OF THIS MAP WAS FOR THE PURPOSE OF IDENTIFYING THE LOCATION OF THE PROPOSED WATER RIGHT AND HAS NO INTENT TO PROVIDE DIMENSIONS OR LOCATION OF PROPERTY LINES.

T 36 S, R 13 W, W.M.,
SECTION 19
FINAL PROOF SURVEY

UNDER

APPLICATION #S-71791

PERMIT #52494

IN THE NAME OF

TIM HUNT

SURVEYED BY H.J. NEWHOUSE, NOVEMBER 26, 1997

SCALE 1" = 400'

