


T. 6 S., R. 1 W., W. M.

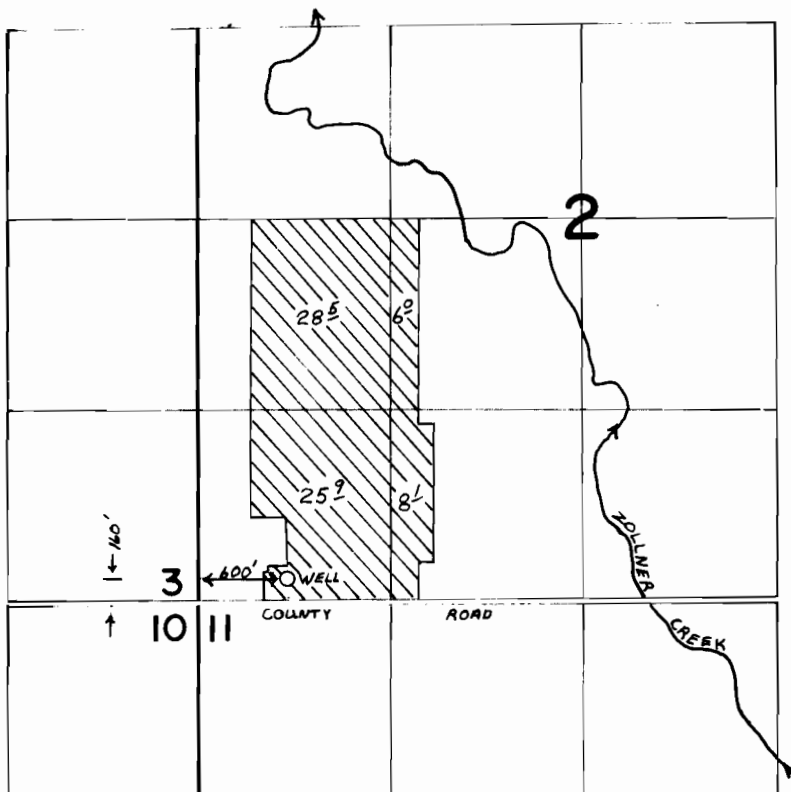

SCALE: 1"=1320'



FINAL PROOF SURVEY UNDER

Application No. G-10845 Permit No. G-9996....
IN NAME OF

ALFRED & ETHEL BERNING

Surveyed Aug. 30.... 19.25., by B.W. BISHOP.....