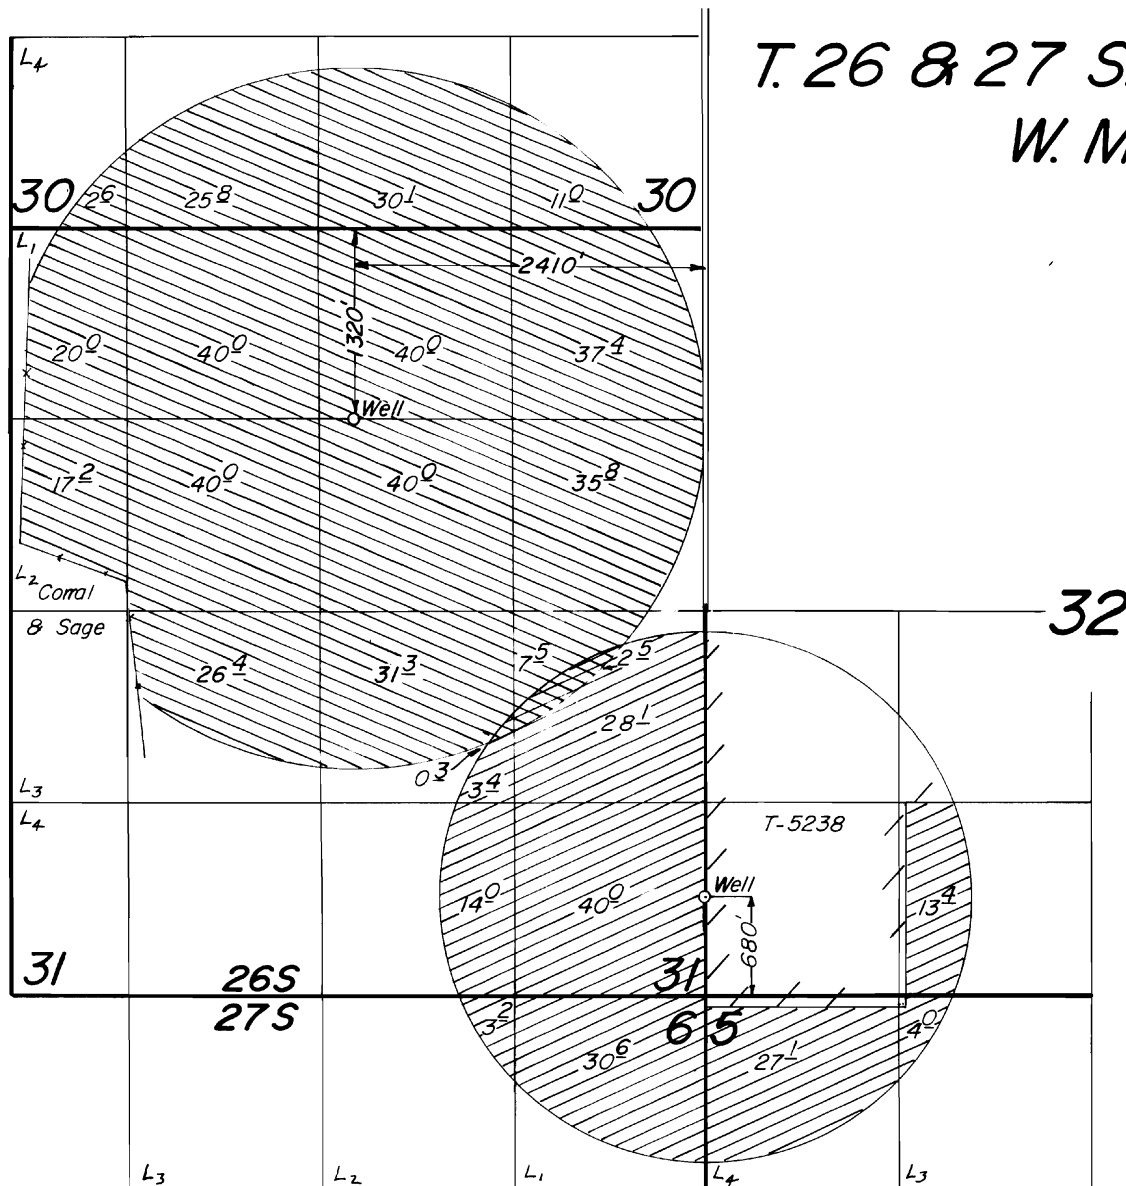


FINAL PROOF SURVEY

UNDER

Transfer # 5238

G- 8195

G- 7848

Application No. G-10927 Permit No. G-10176....

IN NAME OF

ROBERT R. TUTTLE

Surveyed Oct. 10.... 19.85, by T. Warren.....

Primary

Supplemental

