


T.6N.R.34E.W.M.

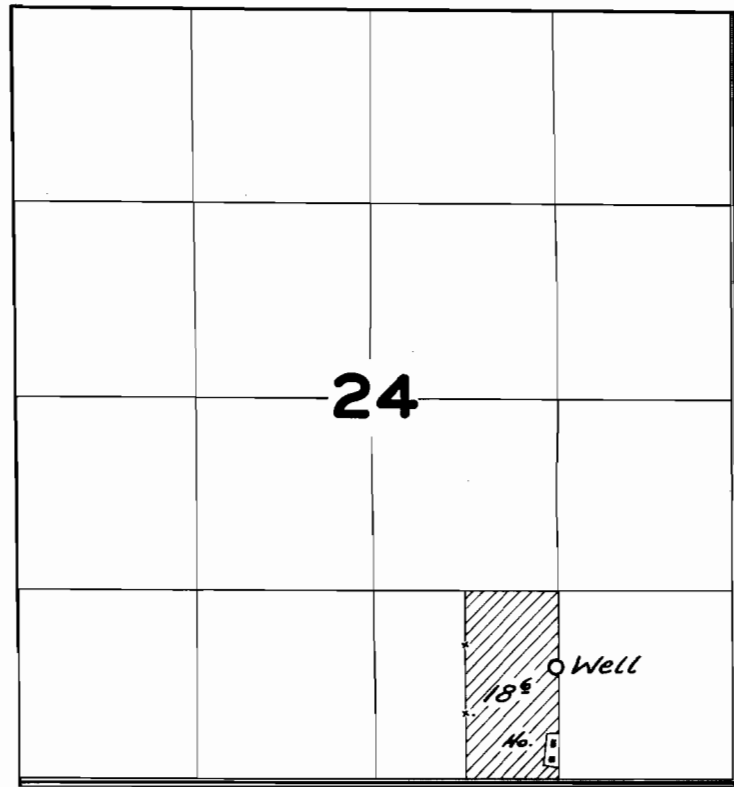

FINAL PROOF SURVEY
UNDER

Application No. *U-503* Permit No. *U-458*
IN NAME OF

Frances Fitzsimmons

Surveyed *May 17, 1954*, by *H.L. Coffman*