


Tax Lot No. TL400 23 12 20BC  
 Section 20 Township 23S Range 12W W.M.  
 Coos County

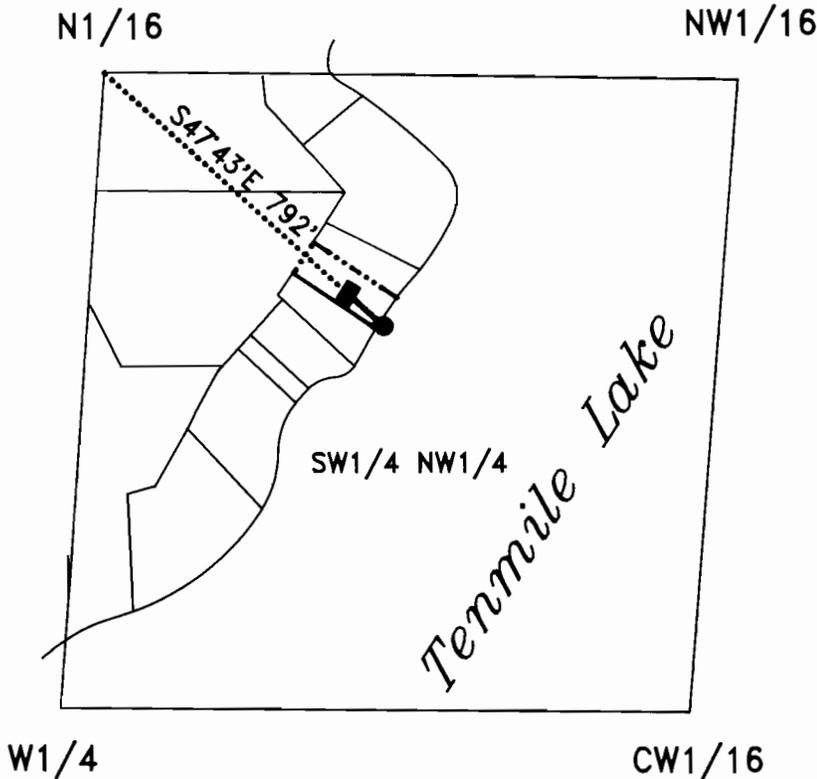

Scale 1" = 400'

Legend

- P.O.D.
- Property Line
- - - - - Waterline
- House


RECEIVED

NOV 3 1987

WATER RES. DIV.  
SALES & ADMIN.

EXAMINERS DISCLAIMER STATEMENT

The preparation of this map was for the purpose of identifying the location of the Water Right only and has no intent to provide dimensions or location of property ownership lines.

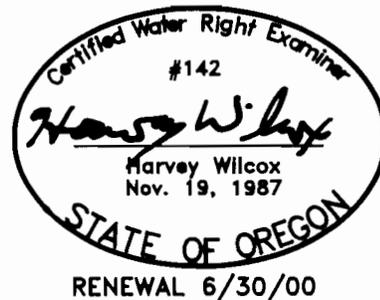

**FINAL PROOF SURVEY**  
 IN THE NAME OF

Janice & Frank Larson

Surveyed on 9/22/98 by H.A. Wilcox

Application No. S-81021  
 Permit No. 53091